

MISSISSIPPI DEPARTMENT OF NATURAL RESOURCES

Bureau of Land and Water Resources

Southport Mall

P.O. Box 10631

Jackson, Mississippi 39209

WATER WELL DRILLERS LOG

Date 9
2054

HICKS WELL CO.
 Rt. 1 Box 157
 Senatobia, MS 38660

5-9 1983
 date well completed

Tate
 county well located

LANDOWNER: A.R. Smart
Pr. 2
Caldwell, Miss. 39118
 (mailing address)

description of formations encountered	depth	
	from	to
<u>Red Clay</u>	<u>0</u>	<u>10</u>
<u>Red Sand</u>	<u>10</u>	<u>60</u>
<u>White Sand</u>	<u>60</u>	<u>110</u>

WELL LOCATION:
 sec. 7 T. 5 N. R. 5 E.
2 miles N of Thyris
 (distance) (direction) (nearest town)

WELL PURPOSE: Home
 (home, irrigation, municipal, industrial)

- WELL COMPLETION DATA:
- (1) diameter (inches) 4
 - (2) total depth (feet) 110
 - (3) static water level (feet) 60 ^{below} above top of ground.
 - (4) casing PVC, 110'
 (material) (depth)
4"
 (size) if telescope see back.
 - (5) screen 10', 100
 (length) (depth to top)
013, PVC
 (size) (material)
 - (6) pump 1/2, 10
 (HP) (yield gpm)
220V
 (type power)
 - (7) electric log no
 (yes or no)
 (organization running log)
 - (8) how well bottom plugged Cap

DRILLERS REMARKS:


DEPT. OF NATURAL RESOURCES
 BUREAU OF LAND & WATER RESOURCES

MAY 25 1983

RECEIVED

If well telescopes please sketch and show depths.

GROUND LEVEL

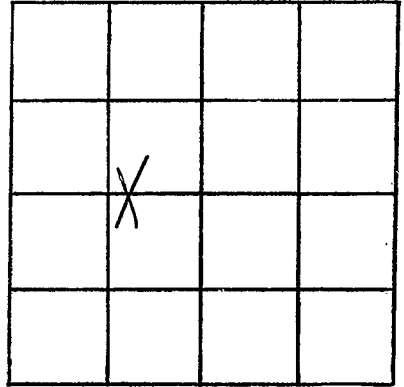

SECTION 7

Please indicate well location X.

ADDITIONAL INFORMATION

If more than one screen,
show locations of each on sketch.