

MISSISSIPPI DEPARTMENT OF NATURAL RESOURCES

Bureau of Land and Water Resources

Southport Mall

P.O. Box 10631

Jackson, Mississippi 39209

WATER WELL DRILLERS LOG

Date
J 2055

3-29-83 <sup>19</sup> LICKS WELL CO. <sup>157</sup> <sup>me</sup> <sup>5</sup> <sup>0000</sup> <sup>157</sup> <sup>me</sup> <sup>5</sup> <sup>0000</sup> <sup>157</sup> <sup>me</sup> <sup>5</sup> <sup>0000</sup>  
 date well completed RL 1, Box 157 county well located *Tate*

LANDOWNER: <i>Another Stage</i>	description of formations encountered	from	to
<i>RL 1</i>			
<i>Senatobia, Miss 38668</i> (mailing address)	<i>Red Sand</i>	<i>0</i>	<i>30</i>
	<i>white Sand</i>	<i>30</i>	<i>135</i>

WELL LOCATION:  
 sec. 19 T 5 N R 5 E  
 (distance) miles (direction) of *Thytus* (nearest town)

WELL PURPOSE: *Home*  
 (home, irrigation, municipal, industrial)

- WELL COMPLETION DATA:
- (1) diameter (inches) 4
  - (2) total depth (feet) 135
  - (3) static water level (feet) 60 <sup>below</sup> <sub>above</sub> top of ground.
  - (4) casing PVC, 135  
 (material) (depth)  
4"  
 (size) if telescope see back.
  - (5) screen 10' 125'  
 (length) (depth to top)  
013 PVC  
 (size) (material)
  - (6) pump 1 18  
 (HP) (yield gpm)  
220V  
 (type power)
  - (7) electric log No  
 (yes or no)

(organization running log)

(8) how well bottom plugged *Cap*

DRILLERS REMARKS:


DEPT. OF NATURAL RESOURCES  
 BUREAU OF LAND & WATER RESOURCES

APR - 4 1983

RECEIVED

If well telescopes please sketch and show depths.

GROUND LEVEL

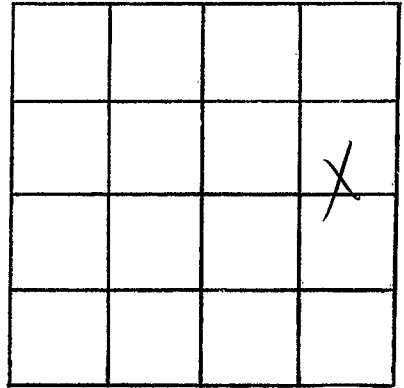

SECTION

19

Please indicate well location X.

ADDITIONAL INFORMATION

If more than one screen, show locations of each on sketch.