

MISSISSIPPI DEPARTMENT OF NATURAL RESOURCES

Bureau of Land and Water Resources

Southport Mall

P.O. Box 10631

Jackson, Mississippi 39209

WATER WELL DRILLERS LOG

HICKS WELL CO.

Rt. 1, Box 157

Senatobia, Miss 38668

Date
J
2086

6-2 19 83
date well completed

Tate
county well located

LANDOWNER: Jerry Latham
No. 1
Senatobia, Miss
(mailing address) 38668
WELL LOCATION:
sec. 28 T. 5 N. R. 5 E. (W)
1 miles S of Aiken
(distance) (direction) (nearest town)

description of formations encountered	from	to
Red Clay	0	20
Red Sand	20	50
(w) White Sand	50	175

WELL PURPOSE: Home
(home, irrigation, municipal, industrial)

WELL COMPLETION DATA:
(1) diameter (inches) 4
(2) total depth (feet) 175
(3) static water level (feet) 100 below above top of ground.
(4) casing PVC, 175 (material) (depth)
4" (size) if telescope see back.
(5) screen 10' 165' (length) (depth to top)
1/2" PVC (size) (material)
(6) pump 1/2 10 (HP) (yield gpm)
220V (type power)
(7) electric log No (yes or no)
(organization running log)
(8) how well bottom plugged Cap

DRILLERS REMARKS:


DEPT. OF NATURAL RESOURCES
BUREAU OF LAND & WATER RESOURCES

JUN 27 1983

RECEIVED

If well telescopes please sketch and show depths.

GROUND LEVEL

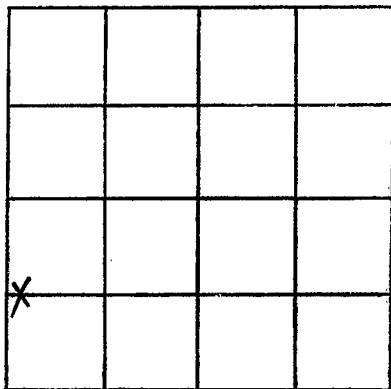

SECTION 28

Please indicate well location X.

ADDITIONAL INFORMATION

If more than one screen,
show locations of each on sketch.