

MISSISSIPPI DEPARTMENT OF NATURAL RESOURCES

Bureau of Land and Water Resources

Southport Mall

P.O. Box 10631

Jackson, Mississippi 39209

WATER WELL DRILLERS-LOG

Date  
5  
2058

1/25 19 84  
 date well completed

HICKS WELL CO.  
 Rt. 1, Box 157  
 Senatobia, MS 38668

Ta to  
 county well located

LANDOWNER: Benny Taylor  
Pct. 1 Box 215  
Senatobia Ms. 38668  
 (mailing address)

description of formations encountered	from	to
Red Clay	0	10
Red Sand	10	40
White Sand & Clay	40	80
White Sand	80	125

WELL LOCATION:  
 sec. 20 T S N R 5 E  
1 miles 1 of Thyges  
 (distance) (direction) (nearest town)

WELL PURPOSE: Home  
 (home, irrigation, municipal, industrial)

WELL COMPLETION DATA:

- (1) diameter (inches) 4
- (2) total depth (feet) 125
- (3) static water level (feet) 60 <sup>below</sup> above top of ground.
- (4) casing PVC, 125,  
 (material) (depth)  
4"  
 (size) If telescope see back.
- (5) screen 10', 115  
 (length) (depth to top)  
1010, PVC  
 (size) (material)
- (6) pump 1/2, 10  
 (HP) (yield gpm)  
220V  
 (type power)
- (7) electric log No  
 (yes or no)  
No  
 (organization running log)
- (8) how well bottom plugged Cay

DRILLERS REMARKS:


DEPT. OF NATURAL RESOURCES  
 BUREAU OF LAND & WATER RESOURCES

JAN 30 1984

RECEIVED

If well telescopes please sketch and show depths.

GROUND LEVEL

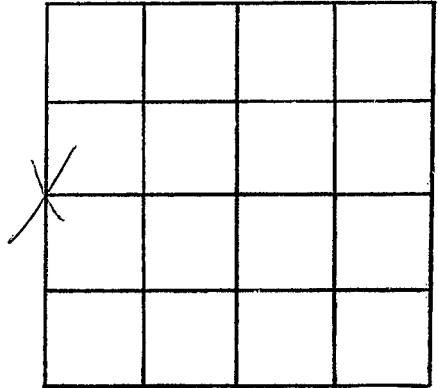

SECTION 20

Please indicate well location X.

ADDITIONAL INFORMATION

If more than one screen,  
show locations of each on sketch.