

MISSISSIPPI DEPARTMENT OF NATURAL RESOURCES

Bureau of Land and Water Resources

Southport Mall

P.O. Box 10631

Jackson, Mississippi 39209

WATER WELL DRILLERS LOG

TATE  
 J  
 2059

NICKS WELL CO.

Tate

6-2 1984  
 date well completed

firm name: NICKS WELL CO.  
 address: 157  
 Cambridge MS 39009

county well located

LANDOWNER: Bobby Davis  
 Pt. 1  
 Senatobia, Ms. 38668  
 (mailing address)

description of formations encountered	from	to
Red clay	0	20
Red sand	20	65
white sand	65	172

WELL LOCATION:  
 sec. 32 T 5 N R 5 E  
 2 miles S of Thytis  
 (distance) (direction) (nearest town)

WELL PURPOSE: Home  
 (home, irrigation, municipal, industrial)

- WELL COMPLETION DATA:
- (1) diameter (inches) 4
  - (2) total depth (feet) 172
  - (3) static water level (feet) 120 below top of ground.
  - (4) casing PVC, 172 (depth)  
 4" (size) if telescope see back.
  - (5) screen 10' (length), 162' (depth to top)  
 1.010 (size), PVC (material)
  - (6) pump 1/2 (HP), 10 (yield gpm)  
 220V (type power)
  - (7) electric log No (yes or no)  
 (organization running log)
  - (8) how well bottom plugged Cap

DEPT. OF NATURAL RESOURCES  
 BUREAU OF LAND & WATER RESOURCES


JUL 10 1984

RECEIVED

DRILLERS REMARKS:

If well telescopes please sketch and show depths.

GROUND LEVEL

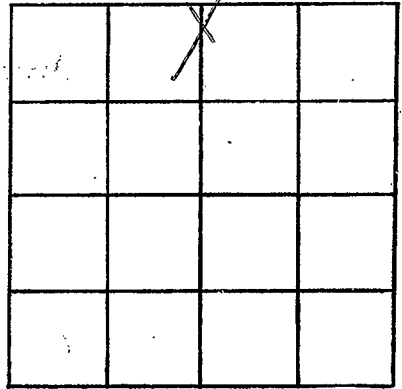

SECTION 32

Please indicate well location X.

ADDITIONAL INFORMATION

If more than one screen, show locations of each on sketch.