

MISSISSIPPI DEPARTMENT OF NATURAL RESOURCES

Bureau of Land and Water Resources

Southport Mall

P.O. Box 10631

Jackson, Mississippi 39209

WATER WELL DRILLERS LOG

Date 8
2000

8-6 19 84
 date well completed

HICKS WELL CO.
 firm name

Tate
 county well located

LANDOWNER: Lesaw Bowen
Rt. 5
Holly Springs, Mo. 38235
 (mailing address)

description of formations encountered	from	to
Red Clay	0	20
Red Sand	20	60
White Sand & Clay	60	120
White Sand	120	230

WELL LOCATION:
 sec. 36 T 5 N R 5 E
2 miles 5 of Wynette
 (distance) (direction) (nearest town)

WELL PURPOSE: Home
 (home, irrigation, municipal, industrial)

- WELL COMPLETION DATA:
- (1) diameter (inches) 4
 - (2) total depth (feet) 230
 - (3) static water level (feet) 150 ^{below}/_{above} top of ground.
 - (4) casing PVC, 230,
 (material) (depth)
4"
 (size) If telescope see back.
 - (5) screen 10', 220'
 (length) (depth to top)
1.010, PVC
 (size) (material)
 - (6) pump 3/4 10
 (HP) (yield gpm)
220V
 (type power)
 - (7) electric log No
 (yes or no)

(organization running log)

(8) how well bottom plugged Cap

DRILLERS REMARKS:


DEPT. OF NATURAL RESOURCES
 BUREAU OF LAND & WATER RESOURCES

SEP 24 1984

RECEIVED

If well telescopes please sketch and show depths.

GROUND LEVEL

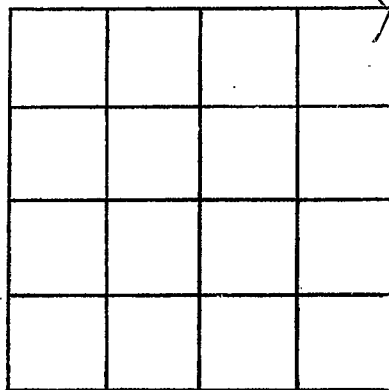

SECTION 36

Please indicate well location X.

ADDITIONAL INFORMATION

If more than one screen, show locations of each on sketch.