

MISSISSIPPI DEPARTMENT OF NATURAL RESOURCES

Bureau of Land and Water Resources

Southport Mall

P.O. Box 10631

Jackson, Mississippi 39209

WATER WELL DRILLERS LOG

Tate
 J 2001
 5-31-85

HICKS WELL CO.
 Box 157
 Senatobia MS 38660

5-31 1985 date well completed
 Tate county well located

LANDOWNER: <u>James Farrow</u>	description of formations encountered	from	to
<u>RT # 2 Box 463</u>			
<u>Caldwater ms 38618</u> (mailing address)	Red clay	0	10
	Red sand	10	50
	White sand & clay	50	80
	White sand	80	140

WELL LOCATION:
 sec. 18 T 5 N R 5 E
 (distance) (direction) (nearest town)
2 miles NW of Thyrida

WELL PURPOSE: home
 (home, irrigation, municipal, industrial)

WELL COMPLETION DATA:

(1) diameter (inches) 4"

(2) total depth (feet) 140'

(3) static water level (feet) 100' below above top of ground.

(4) casing PVC, 130,
 (material) (depth)
4" If telescope see back.
 (size)


(5) screen 10', 130'
 (length) (depth to top)
010, PVC
 (size) (material)

(6) pump 3/4 10
 (HP) (yield gpm)
220 Electric
 (type power)

(7) electric log No
 (yes or no)
 (organization running log)

(8) how well bottom plugged Cap


DRILLERS REMARKS:

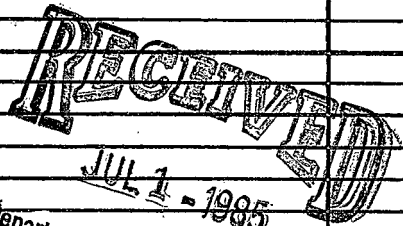

Department of Natural Resources
 Bureau of Land & Water Resources

If well telescopes please sketch and show depths.

GROUND LEVEL

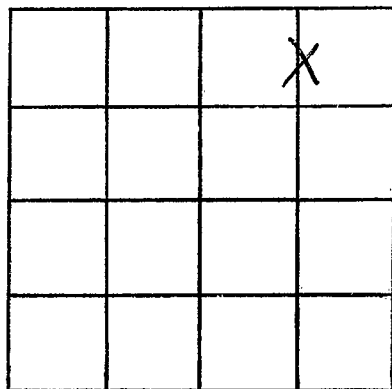

SECTION 18

Please indicate well location X.

ADDITIONAL INFORMATION

If more than one screen,
show locations of each on sketch.