

MISSISSIPPI DEPARTMENT OF NATURAL RESOURCES

Bureau of Land and Water Resources

Southport Mall

P.O. Box 10631

Jackson, Mississippi 39209

WATER WELL DRILLERS LOG

HICKS WELL COMPANY

RT. 1, BOX 157

firm name
SENATOBIA, MISS.

J Good
Tate
6-1-85

6-1 19 85
date well completed

Tate
county well located

LANDOWNER: Harry B. Robertson

Description of formations encountered

from to

Rt #1

Red Clay

0 10

Senatobia MS 38688
(mailing address)

Red Sand

10 50

WELL LOCATION:

sec. 19 T 5 N R 5 E
S W
1 miles W of Thyatira
(distance) (direction) (nearest town)

White Sand

50 170

WELL PURPOSE: Home
(home, irrigation, municipal, industrial)

WELL COMPLETION DATA:

- (1) diameter (inches) 4"
- (2) total depth (feet) 170'
- (3) static water level (feet) 150' below top of ground.
- (4) casing PVC, 140' (depth)
4" (size) if telescope see back.
- (5) screen 10' (length), 140' (depth to top)
1/3 (size), PVC (material)
- (6) pump 3/4 (HP), 10 (yield gpm)
220V (type power)
- (7) electric log NO
(yes or no)

(organization running log)

(8) how well bottom plugged Cap

RECEIVED


SEP 26 1985

DRILLERS REMARKS:

Department of Natural Resources
Bureau of Land & Water Resources

If well telescopes please sketch and show depths.

GROUND LEVEL

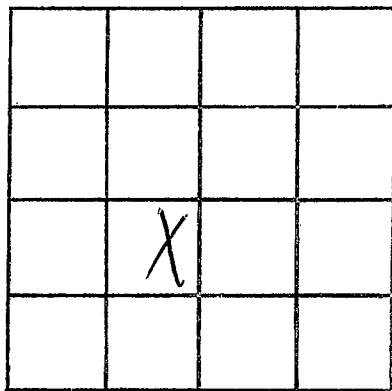

SECTION 19

Please indicate well location X.

ADDITIONAL INFORMATION

If more than one screen,
show locations of each on sketch.