

MISSISSIPPI DEPARTMENT OF NATURAL RESOURCES

Bureau of Land and Water Resources

Southport Mall

P.O. Box 10631

Jackson, Mississippi 39209

WATER WELL DRILLERS LOG

DATE

HICKS WELL COMPANY

Date

9-16 1985
 date well completed

Rt. 1 - Box 156

county well located

SENATOBIA, MISS.

LANDOWNER: Trey Smart

description of formations encountered

from to

ht #2

Colchester ms 39618
 (mailing address)

Red clay

0 10

red sand

10 30

white sand

30 125

WELL LOCATION:

sec. 7 T 5 N R 5 E
 S W
2 miles N of Thyerica
 (distance) (direction) (nearest town)

WELL PURPOSE: X-band
 (home, irrigation, municipal, industrial)

WELL COMPLETION DATA:

- (1) diameter (inches) 4"
- (2) total depth (feet) 125"
- (3) static water level (feet) 60' ^{below} above top of ground.
- (4) casing PVC 115'
 (material) (depth)
4" if telescope see back.
 (size)
- (5) screen 10' 115'
 (length) (depth to top)
013 PVC
 (size) (material)
- (6) pump 1/2 10
 (HP) (yield gpm)
220V
 (type power)
- (7) electric log NO
 (yes or no)

(organization running log)

(8) how well bottom plugged Cap


RECEIVED
 DEC 1 8 1985

DRILLERS REMARKS:

Department of Natural Resources
 Bureau of Land & Water Resources

If well telescopes please sketch and show depths.

GROUND LEVEL

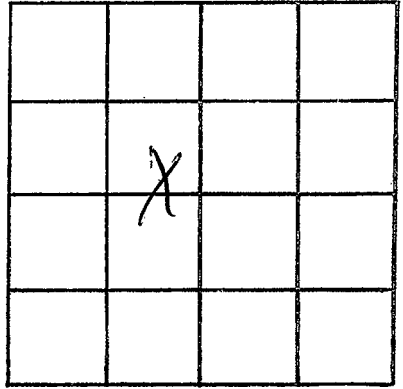

SECTION 7

Please indicate well location X.

ADDITIONAL INFORMATION

If more than one screen, show locations of each on sketch.