

MISSISSIPPI DEPARTMENT OF NATURAL RESOURCES

Bureau of Land and Water Resources

Southport Mall

P.O. Box 10631

Jackson, Mississippi 39209

WATER WELL DRILLERS LOG

HICKS WELL COMPANY

TATE
Jackie

11-23 1985
date well completed

RT. 1, BOX 157
firm name
SENATOBIA, MISS.

Date
county well located

LANDOWNER: James Shank
Rt # 2
Caldwate, MS 38618
(mailing address)

description of formations encountered	from to	
Red clay	0	10
Red loam	10	30
white sand	30	155

WELL LOCATION:
sec. 8 T 5 N R 5 E
S W
2 miles S of Bett
(distance) (direction) (nearest town)

WELL PURPOSE: Drone
(home, irrigation, municipal, industrial)

WELL COMPLETION DATA:

- (1) diameter (inches) 4"
- (2) total depth (feet) 155'
- (3) static water level (feet) 100' ^{below} above top of ground.
- (4) casing PVC, 145'
(material) (depth)
4" if telescope see back.
(size)
- (5) screen 10', 145'
(length) (depth to top)
0/3, PVC
(size) (material)
- (6) pump 1/2, 10
(HP) (yield gpm)
200 V
(type power)
- (7) electric log NO
(yes or no)

(organization running log)

(8) how well bottom plugged Cap


RECEIVED
DEC 16 1985

DRILLERS REMARKS:

Department of Natural Resources
Bureau of Land & Water

If well telescopes please sketch and show depths.

GROUND LEVEL

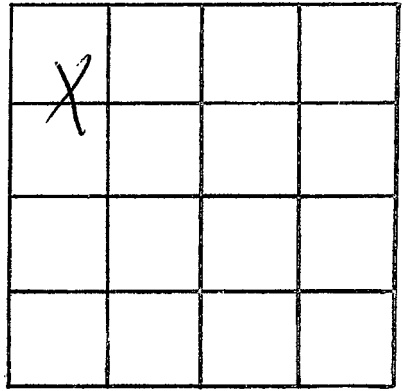

SECTION 8

Please indicate well location X.

ADDITIONAL INFORMATION

If more than one screen, show locations of each on sketch.