

MISSISSIPPI DEPARTMENT OF NATURAL RESOURCES

Bureau of Land and Water Resources

Southport Mall

P.O. Box 10631

Jackson, Mississippi 39209

WATER WELL DRILLERS LOG

TATE
Jacob

2-13 1986 Gullett Water Well Tate  
 date well completed firm name county well located

LANDOWNER: Jessie Holliman  
 County Line Rd.  
 Hernando, Ms  
 (mailing address)

description of formations encountered	from	to
loam soil	0	3
white sand & clay	3	110
white sand	110	170

WELL LOCATION:  
 sec. 2 T 5 N R 5 E  
 3 miles S of Bet  
 (distance) (direction) (nearest town)

WELL PURPOSE: Home  
 (home, irrigation, municipal, industrial)

WELL COMPLETION DATA:

(1) diameter (inches) 4"

(2) total depth (feet) 180'

(3) static water level (feet) 130' below top of ground.

(4) casing PVC, 170', (material) (depth)  
 4" (size) If telescope see back.

(5) screen 10', 170' (length) (depth to top)  
 4" (size) PVC (material)


(6) pump 3/4 HP, 10 (yield gpm)  
 Elec (type power)

(7) electric log NO (yes or no)

(organization running log)

(8) how well bottom plugged Cap


DRILLERS REMARKS:

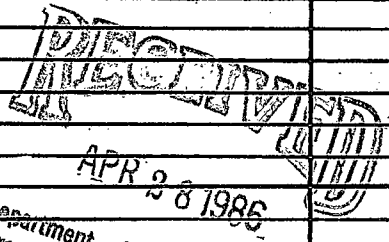

Department of Natural Resources  
 Bureau of Land & Water Resources

If well telescopes please sketch and show depths.

GROUND LEVEL

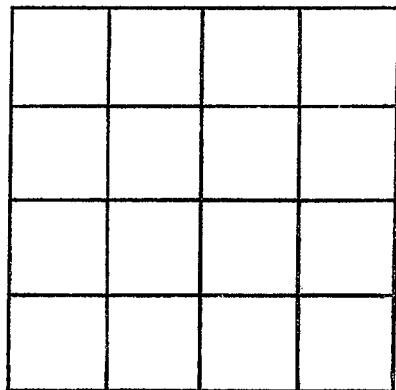

SECTION \_\_\_\_\_

Please indicate well location X.

ADDITIONAL INFORMATION

If more than one screen,  
show locations of each on sketch.