

MISSISSIPPI DEPARTMENT OF NATURAL RESOURCES

Bureau of Land and Water Resources

Southport Mall

P.O. Box 10631

Jackson, Mississippi 39209

WATER WELL DRILLERS LOG

DATE
Jan 89

4-25

date well completed

86 Sullet Water Well

firm name

Date

county well located

LANDOWNER: Earl McCrite

description of formations encountered

from to

413 Central Ave
Muscle Shoals, Al.
(mailing address)

Top Soil	0'	2'
Red Clay	2	20'
Red Sand Clay	20	80'
White Sand Clay	80	140
White Sand	140	180

WELL LOCATION:

sec. 14 T. 5 N. R. 5 E
0 miles of Wyatte
(distance) (direction) (nearest town)


WELL PURPOSE: home
(home, irrigation, municipal, industrial)

WELL COMPLETION DATA:

- (1) diameter (inches) 4"
- (2) total depth (feet) 180'
- (3) static water level (feet) 130' below top of ground.
- (4) casing PVC, 170'
(material) (depth)
4" if telescope see back.
(size)
- (5) screen 10', 170'
(length) (depth to top)
4" PVC
(size) (material)
- (6) pump 1/2, 10
(HP) (yield gpm)
Elec
(type power)
- (7) electric log No
(yes or no)

(organization running log)

(8) how well bottom plugged Cap

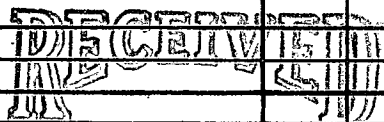


AUG 11 1986

Department of Natural Resources
Bureau of Land & Water Resources

DRILLERS REMARKS:

If well telescopes please sketch and show depths.

GROUND LEVEL

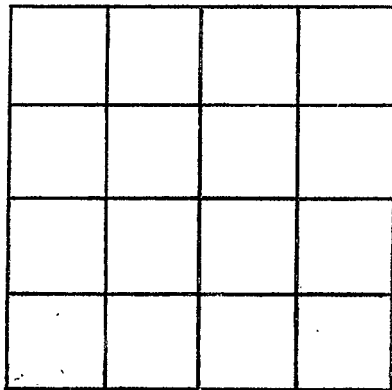

SECTION _____

Please indicate well location X.

ADDITIONAL INFORMATION

If more than one screen,
show locations of each on sketch.