

MISSISSIPPI DEPARTMENT OF NATURAL RESOURCES

Bureau of Land and Water Resources

Southport Mall

P.O. Box 10631

Jackson, Mississippi 39209

WATER WELL DRILLERS LOG

DATE
5 20 70

3-14 1986
date well completed

Fuller Water Well
firm name

Ita
county well located

LANDOWNER: W. Merritt
Rt 1
Senatobia, Mo.
(mailing address)

description of formations encountered


from	to
0	2'
2'	20'
20'	80'
80'	140'
140'	180'

Top Soil
Old Clay
Red sandy clay
White sand clay
White Sand

WELL LOCATION:
sec. 20 T. 5 N. R. 5 E.
0 miles (distance) of Ita (direction) (nearest town)

WELL PURPOSE: Home
(home, irrigation, municipal, industrial)

- WELL COMPLETION DATA:
- (1) diameter (inches) 4"
 - (2) total depth (feet) 180'
 - (3) static water level (feet) 130' below top of ground.
 - (4) casing PVC, 170' (material) (depth)
4" (size) If telescope see back.
 - (5) screen 10', 170' (length) (depth to top)
4" (size) PVC (material)
 - (6) pump 1/2, 10 (HP) (yield gpm)
Elec. (type power)
 - (7) electric log No (yes or no)

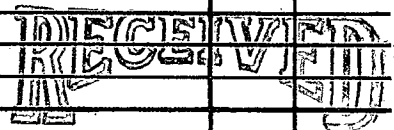

AUG 11 1986


Department of Natural Resources
Bureau of Land & Water Resources

(organization running log) Cap
(8) how well bottom plugged Drift

DRILLERS REMARKS:

If well telescopes please sketch and show depths.

GROUND LEVEL

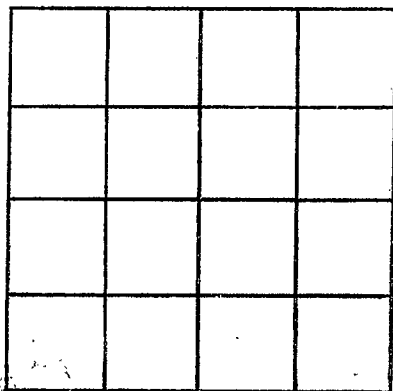

SECTION _____

Please indicate well location X.

ADDITIONAL INFORMATION

If more than one screen,
show locations of each on sketch.