

MISSISSIPPI DEPARTMENT OF NATURAL RESOURCES

Bureau of Land and Water Resources

COUNTY WELL LOCATED	
<i>STATE</i>	
WELL NUMBER	CODED
<i>2988</i>	
DATE WELL COMPLETED	
<i>10-31-90</i>	

PERMIT NUMBER
HICKS WELL CO.
NAME OF DRILLING FIRM
RT. 1 BOX 157
SENATOBIA, MS 38668

P.O. Box 10631
Jackson, Mississippi 39209
WATER WELL DRILLERS LOG

NAME & MAILING ADDRESS OF LANDOWNER			
<i>Burton Hyde</i>			
<i>Russellville</i>			
<i>ARK</i>			
WELL LOCATION:	SEC	TOWNSHIP	RANGE
	<i>19</i>	<i>5 N</i>	<i>5 W</i>
DISTANCE	DIRECTION	NEAREST TOWN	
<i>1 1/4</i> Miles	<i>E</i>	of <i>SENATOBIA</i>	
OTHER LANDMARK			
WELL PURPOSE: Home, Irrigation, Municipal, Industrial, Fish Pond, etc.			

PUMP DATA			
PUMP TYPE (Circle One):			
<input checked="" type="radio"/> Submersible Turbine Jet Flowing Well,			
Other (Describe) _____			
POWER TYPE (Circle One):			
<input checked="" type="radio"/> Electric Tractor, Diesel, Gasoline, Butane,			
Other (Describe) _____ H/P <i>3/4</i>			
Pump Capacity (GPM)	No. of Stages	Setting Depth	
<i>10</i>	<i>12</i>	<i>140</i> FT.	
PUMP TEST			
Well yielded _____ <i>10</i> _____ GPM with			
a drawdown of _____ ft.			
after _____ hours of pumping			

WELL DATA			
Well Depth	Casing Diameter (In.)	Casing Length (Ft.)	
<i>200</i>	<i>4"</i>	<i>10'</i>	
Type of Casing	Hole Depth	Depth to Static Water Level	
<i>PVC</i>	<i>200</i>	<i>120</i>	
TYPE OF COMPLETION: (Circle One or More):			
Gravel Packed, Underreamed, Telescoped,			
Natural Development, Open Hole, Other			
(Describe) _____			
Top of Lap Pipe or Reduction in Casing			
FEET	IF TELESCOPED OR MORE THAN ONE SCREEN: USE BACK PAGE		

LOG DATA			
TYPE OF LOG RUN (Circle One):			
<input type="radio"/> No Log Run, Electric, Gamma Ray, Density, Sonic, Neutron,			
Other (Describe) _____			
Name of Organization Running Log			

SCREEN DATA			
Diameter - Inches	Length - Feet	Slot Size - Inches	
<i>4"</i>	<i>10'</i>	<i>0.13</i>	
Screen Type	Depth to Bottom - Feet		
<i>PVC</i>	<i>10'</i>		


GEOLOGIC DATA (Office Use Only)			
Surface Elev.	Geologic Unit	Unit Thickness	Depth to Top
Subs. SWL	Date	Analysis	Aquifer Test
Driller's Remarks			

DESCRIPTION OF FORMATIONS ENCOUNTERED	FROM	TO	FORMATIONS (Continued)	FROM	TO
<i>RC</i>	<i>0</i>	<i>10</i>	RECEIVED NOV 16 1990 Department of Natural Resources Bureau of Land & Water Resources		
<i>RC & S</i>	<i>10</i>	<i>90</i>			
<i>WC & S</i>	<i>90</i>	<i>160</i>			
<i>WS</i>	<i>160</i>	<i>200</i>			

IF MORE SPACE IS NEEDED, USE BACK

If well telescopes please
sketch and show depths.

GROUND LEVEL

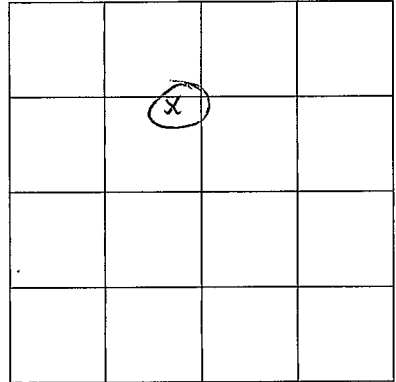

SECTION _____

Please indicate well location X.

ADDITIONAL INFORMATION

A series of horizontal lines for writing additional information.

If more than one screen,
show location of each on sketch.