

MISSISSIPPI DEPARTMENT OF ENVIRONMENTAL QUALITY

Office of Land and Water Resources

COUNTY WELL LOCATED
Tate

WELL NUMBER
J

CODED

DATE WELL COMPLETED
2/04
8-8-94

PERMIT NUMBER
HICKS WELL CO.

NAME OF DRILLER/FIRM
RT. 1 BOX 157
SENATOBIA, MS 38668

P. O. Box 10631
Jackson, MS 39289-0631
WATER WELL DRILLERS LOG

NAME & MAILING ADDRESS OF LANDOWNER
Roy L. Sanders
3801 Kerston Dr
Memphis TENN 38128

WELL LOCATION: SEC TOWNSHIP RANGE
19 5 N 5 W

DISTANCE DIRECTION NEAREST TOWN
12 Miles EAST of Senatobia

OTHER LANDMARK

WELL PURPOSE (Home) Irrigation, Municipal, Industrial, Fish Pond, etc.

PUMP DATA

PUMP TYPE (Circle One):
Submersible, Turbine, Jet, Flowing Well,
Other (Describe)

POWER TYPE (Circle One):
Electric, Tractor, Diesel, Gasoline, Butane,
Other (Describe) H/P 3/4

Pump Capacity (GPM) No. of Stages Setting Depth
10 9BC 160 FT.

PUMP TEST

Well yielded _____ GPM with
a drawdown of _____ ft.
after _____ hours of pumping

WELL DATA

Well Depth Casing Diameter (In.) Casing Length (Ft.)
200' 4" 190'

Type of Casing Hole Depth Depth to Static Water Level
PVC 200' 140'

TYPE OF COMPLETION: (Circle One or More):
Gravel Packed, Underreamed, Telescoped,
Natural Development, Open Hole, Other
(Describe)

WELL GROUTED TO A DEPTH OF 3 FEET
Type Grout (circle one) Cement, Bentonite, or Mix

LOG DATA

TYPE OF LOG RUN (Circle One):
No Log Run, Electric, Gamma Ray, Density, Sonic, Neutron,
Other (Describe)

Name of Organization Running Log

SCREEN DATA

Diameter - Inches Length - Feet Slot Size - Inches
4" 10' .013

Screen Type Depth to Bottom - Feet
PVC 200'

GEOLOGIC DATA (Office Use Only)

Surface Elev.	Geologic Unit	Unit Thickness	Depth to Top
Subs. SWL	Date	Analysis	Aquifer Test

Driller's Remarks

Top of Lap Pipe or Reduction in Casing


FEET IF TELESCOPED OR MORE THAN ONE SCREEN: USE BACK PAGE

DESCRIPTION OF FORMATIONS ENCOUNTERED	FROM	TO	FORMATIONS (Continued)	FROM	TO
<u>Red Sand</u>	<u>0</u>	<u>60</u>	RECEIVED DEC 21 1994 Dept. of Environmental Quality Office of Land & Water Resources		
<u>Sand & Clay</u>	<u>60</u>	<u>160</u>			
<u>White Sand</u>	<u>160</u>	<u>200</u>			

IF MORE SPACE IS NEEDED, USE BACK

If well telescopes please sketch and show depths.

GROUND LEVEL

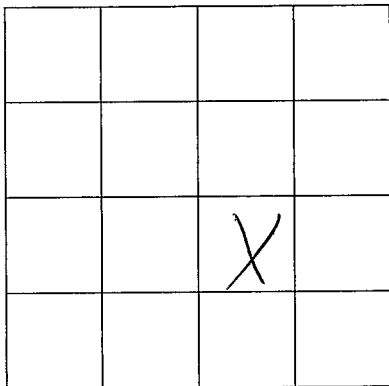

SECTION 19

Please indicate well location X.

ADDITIONAL INFORMATION

If more than one screen, show location of each on sketch.