

**MISSISSIPPI DEPARTMENT OF ENVIRONMENTAL QUALITY**

Office of Land and Water Resources

P. O. Box 10631

Jackson, MS 39289-0631

WATER WELL DRILLERS LOG

COUNTY WELL LOCATED <b>TATE</b>	
WELL NUMBER <b>2</b>	CODED
<b>2105</b>	
DATE WELL COMPLETED <b>3-30-95</b>	

PERMIT NUMBER <b>HICKS WELL CO.</b>
NAME OF DRILLING FIRM <b>RT BOX 157</b>
<b>SENATOLIA, MS 38668</b>

NAME & MAILING ADDRESS OF LANDOWNER <b>James Tiner</b>			
<b>27105 Hw 4</b>			
<b>Senatobia, MS</b>			
WELL LOCATION: SEC	TOWNSHIP	RANGE	
<b>17</b>	<b>5</b>	<b>N</b>	<b>5</b>
		<b>S</b>	<b>W</b>
DISTANCE	DIRECTION	NEAREST TOWN	
<b>15</b> Miles	<b>E</b>	of <b>Senatobia</b>	
OTHER LANDMARK			
WELL PURPOSE <input checked="" type="checkbox"/> Home, <input type="checkbox"/> Irrigation, <input type="checkbox"/> Municipal, <input type="checkbox"/> Industrial, <input type="checkbox"/> Fish Pond, etc.			

<b>PUMP DATA</b>		
PUMP TYPE (Circle One): <input checked="" type="checkbox"/> Submersible, <input type="checkbox"/> Turbine, <input type="checkbox"/> Jet <input type="checkbox"/> Flowing Well, Other (Describe) _____		
POWER TYPE (Circle One): <input checked="" type="checkbox"/> Electric, <input type="checkbox"/> Tractor, <input type="checkbox"/> Diesel, <input type="checkbox"/> Gasoline, <input type="checkbox"/> Butane, Other (Describe) _____ H/P <b>3/4</b>		
Pump Capacity (GPM) <b>10</b>	No. of Stages <b>12</b>	Setting Depth <b>160</b> FT.
PUMP TEST		
Well yielded _____ GPM with a drawdown of _____ ft. after _____ hours of pumping		

<b>WELL DATA</b>		
Well Depth <b>195'</b>	Casing Diameter (In.) <b>4"</b>	Casing Length (Ft.) <b>185'</b>
Type of Casing <b>PVC</b>	Hole Depth <b>195'</b>	Depth to Static Water Level <b>140'</b>
TYPE OF COMPLETION: (Circle One or More): <input checked="" type="checkbox"/> Gravel Packed, <input type="checkbox"/> Underreamed, <input type="checkbox"/> Telescoped, <input type="checkbox"/> Natural Development, <input type="checkbox"/> Open Hole, <input type="checkbox"/> Other (Describe) _____		
WELL GROUTED TO A DEPTH OF <b>10</b> FEET Type Grout (circle one): <input checked="" type="checkbox"/> Cement, <input type="checkbox"/> Bentonite, or Mix		

<b>LOG DATA</b>	
TYPE OF LOG RUN (Circle One): <input type="checkbox"/> No Log Run, <input type="checkbox"/> Electric, <input type="checkbox"/> Gamma Ray, <input type="checkbox"/> Density, <input type="checkbox"/> Sonic, <input type="checkbox"/> Neutron, Other (Describe) _____	
Name of Organization Running Log	

<b>SCREEN DATA</b>		
Diameter - Inches <b>4"</b>	Length - Feet <b>10'</b>	Slot Size - Inches <b>013</b>
Screen Type <b>PVC</b>	Depth to Bottom - Feet <b>10'</b>	

<b>GEOLOGIC DATA (Office Use Only)</b>			
Surface Elev.	Geologic Unit	Unit Thickness	Depth to Top
Subs. SWL	Date	Analysis	Aquifer Test
Driller's Remarks			
Top of Lap Pipe or Reduction in Casing			
FEET		IF TELESKOPED OR MORE THAN ONE SCREEN: USE BACK PAGE	

DESCRIPTION OF FORMATIONS ENCOUNTERED	FROM	TO	FORMATIONS (Continued)	FROM	TO
<b>Red Sand</b>	<b>0</b>	<b>100</b>			
<b>Sand + Clay</b>	<b>100</b>	<b>140</b>			
<b>White Sand</b>	<b>140</b>	<b>195</b>			

**RECEIVED**


**JUL 24 1995**

**Dept. of Environmental Quality  
Office of Land & Water Resources**

IF MORE SPACE IS NEEDED, USE BACK

If well telescopes please sketch and show depths.

GROUND LEVEL

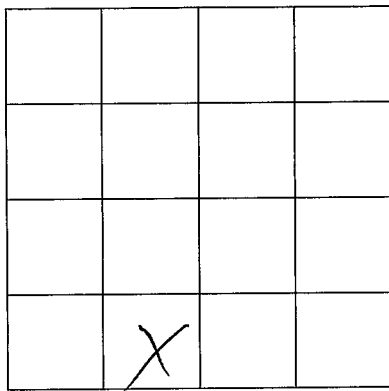

SECTION 17

Please indicate well location X.

ADDITIONAL INFORMATION

If more than one screen,  
show location of each on sketch.