

MISSISSIPPI DEPARTMENT OF ENVIRONMENTAL QUALITY

Office of Land and Water Resources

P. O. Box 10631
Jackson, MS 39289-0631
WATER WELL DRILLERS LOG

COUNTY WELL LOCATED TATE	
WELL NUMBER J-2125	CODED
DATE WELL COMPLETED 3-28-00	

PERMIT NUMBER HICKS WELL CO.
NAME OF DRILLING FIRM S...

NAME & MAILING ADDRESS OF LANDOWNER Magnolia Properties % Tom Coffelt 8544 Caroma # 14 Olive Branch, MS 38654			
WELL LOCATION: SEC	TOWNSHIP	RANGE	
22	5	N	5
DISTANCE DIRECTION NEAREST TOWN 1 1/2 Miles W of Wyatte			
OTHER LANDMARK Rolling Hills Estates Sub.			
WELL PURPOSE: Home, Irrigation, Municipal, Industrial, Fish Pond, etc. small subdivision 8 lots			

PUMP DATA		
PUMP TYPE (Circle One): <input checked="" type="radio"/> Submersible Turbine, Jet, Flowing Well, Other (Describe)		
POWER TYPE (Circle One): <input checked="" type="radio"/> Electric, Tractor, Diesel, Gasoline, Butane, Other (Describe) H/P 1 1/2		
Pump Capacity (GPM) 20	No. of Stages	Setting Depth 160 FT.
PUMP TEST Well yielded no GPM with a drawdown of 108 ft. after 108 hours of pumping		

WELL DATA		
Well-Depth 190	Casing Diameter (In.) 4	Casing Length (Ft.) 170
Type of Casing PVC	Hole Depth 190	Depth to Static Water Level 120

LOG DATA			
TYPE OF LOG RUN (Circle One): <input checked="" type="radio"/> No Log Run Electric, Gamma Ray, Density, Sonic, Neutron, Other (Describe)			
Name of Organization Running Log			

TYPE OF COMPLETION: (Circle One or More): <input checked="" type="radio"/> Gravel Packed, Underreamed, Telescoped, Natural Development, Open Hole, Other (Describe)			
--	--	--	--

RECEIVED			
GEOLOGIC DATA (Official Use Only)			
Surface Elev.	Geologic Unit	Unit Thickness	Depth to Top
Subs. SWL	Date	Analysis	Aquifer Test
MAY 10 2000			

WELL GROUTED TO A DEPTH OF 3 FEET	
Type Grout (circle one): Cement, <input checked="" type="radio"/> Bentonite, or Mix	


Driller's Remarks	
Dept. of Environmental Quality	
Office of Land and Water Resources	
Top of Pipe	FEET
IF TELESCOPED OR MORE THAN ONE SCREEN: USE BACK PAGE	

SCREEN DATA		
Diameter - Inches 4	Length - Feet 20	Slot Size - Inches .013
Screen Type PVC slotted	Depth to Bottom - Feet 170	

DESCRIPTION OF FORMATIONS ENCOUNTERED	FROM	TO	FORMATIONS (Continued)	FROM	TO
Soil	0	10			
Red Sand	10	50			
White Sand & Clay	50	60			
White Sand	60	105			
White Clay	105	120			
White Sand	120	190			
IF MORE SPACE IS NEEDED, USE BACK					

If well telescopes please sketch and show depths.

GROUND LEVEL

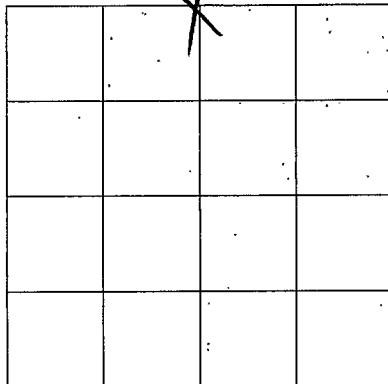

SECTION 22

Please indicate well location X.

ADDITIONAL INFORMATION

If more than one screen, show location of each on sketch.