

MISSISSIPPI DEPARTMENT OF ENVIRONMENTAL QUALITY
Office of Land and Water Resources

P. O. Box 10631
Jackson, MS 39289-0631
WATER WELL DRILLERS LOG

COUNTY, WELL LOCATED LATA	
WELL NUMBER 262	CODED
8-2134	
DATE WELL COMPLETED 6-28-01	

PERMIT NUMBER
NAME OF DRILLING FIRM SMITH WELL DRILLING & SEAL

NAME & MAILING ADDRESS OF LANDOWNER BOWEN			
WILMOT MS.			
562-3008			
WELL LOCATION: SEC	TOWNSHIP	RANGE	
J-2	T-5	R-5	W
DISTANCE	DIRECTION	NEAREST TOWN	
3 Miles	N	of WILMOT	
OTHER LANDMARK			
WELL PURPOSE: Home, Irrigation, Municipal, Industrial, Fish Pond, etc. Home			

PUMP DATA			
PUMP TYPE (Circle One): <input checked="" type="radio"/> Submersible, Turbine, Jet, Flowing Well, Other (Describe) _____			
POWER TYPE (Circle One): <input checked="" type="radio"/> Electric, Tractor, Diesel, Gasoline, Butane, Other (Describe) _____ H/P 3/2			
Pump Capacity (GPM)	No. of Stages	Setting Depth	
12	10	40 FT.	
PUMP TEST			
Well yielded 20 GPM with a drawdown of 3 ft. after 1 hours of pumping			

WELL DATA		
Well Depth 104	Casing Diameter (In.) 4"	Casing Length (Ft.) 94
Type of Casing PVC	Hole Depth 104	Depth to Static Water Level 14

LOG DATA	
TYPE OF LOG RUN (Circle One): No Log Run, Electric, Gamma Ray, Density, Sonic, Neutron, Other (Describe) _____	
Name of Organization Running Log	

TYPE OF COMPLETION: (Circle One or More): Gravel Packed, Underreamed, Telescoped, Natural Development, Open Hole, Other (Describe) WATER SAND	
WELL GROUTED TO A DEPTH OF 20 FEET Type Grout (circle one): <input checked="" type="radio"/> Cement, Bentonite, or Mix	

GEOLOGIC DATA (Office Use Only)			
Surface Elev.	Geologic Unit	Unit Thickness	Depth to Top
Subs. SWL	Date	Analysis	Aquifer Test

SCREEN DATA		
Diameter - Inches 4"	Length - Feet 10	Slot Size - Inches 1/4 THOUS
Screen Type PVC	Depth to Bottom - Feet 104	


Driller's Remarks
RECD DEC 31 2001
Top of Lap Pipe or Reduction in Casing
FEET IF TELESCOPED OR MORE THAN ONE SCREEN: USE BACK PAGE

DESCRIPTION OF FORMATIONS ENCOUNTERED	FROM	TO	FORMATIONS (Continued)	FROM	TO
TOP SOIL	0	10			
WHITE CLAY + SAND	10	40			
WHITE SAND + CLAY	40	100			
WHITE SAND	70	104			

IF MORE SPACE IS NEEDED, USE BACK

If well telescopes please
sketch and show depths.

GROUND LEVEL

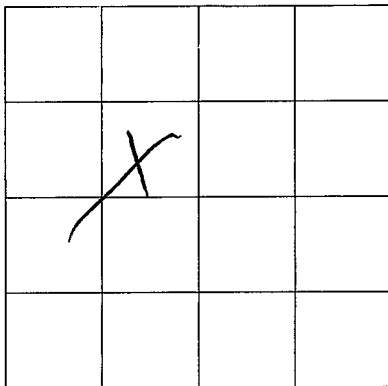

SECTION *J-2*

Please indicate well location X.

ADDITIONAL INFORMATION

If more than one screen,
show location of each on sketch.