

MISSISSIPPI
BOARD OF WATER COMMISSIONERS
416 North State Street
Jackson, Mississippi 39201

CODED

WATER WELL DRILLERS LOG

TATE
K6
2-15-71

2-15 1971 Harris Bros. Tate
date well completed firm name county well located

LANDOWNER: Dr. John Crews
Pt. 1
Sarah
(mailing address)

description of formations encountered	from	to
top soil	0	20
sand & pea gravel	20	50
grey clay	50	120
clay & fine sand	120	245
coarse sand	245	270

WELL LOCATION:
sec. 3 T 6 N R 9 E
2 miles S of Shannon
(distance) (direction) (nearest town)

WELL PURPOSE: none
(home, irrigation, municipal, industrial)

- WELL COMPLETION DATA:
- (1) diameter (inches) 4
 - (2) total depth (feet) 270
 - (3) static water level (feet) 20 ^{below}/_{above} of ground.
 - (4) casing plastic 256
(material) (depth)
4 (size) if telescope see back.
 - (5) screen 14' 256
(length) (depth to top)
008 plastic
(size) (material)
 - (6) pump 3/4 7
(HP) (yield gpm)
elec.
(type power)
 - (7) electric log no
(yes or no)
- (organization running log)
- (8) how well bottom plugged well
spot

CODED


MAY 14 1971

DRILLERS REMARKS:

MISS. BD. OF
WATER COMM.

If well telescopes please sketch and show depths.

GROUND LEVEL

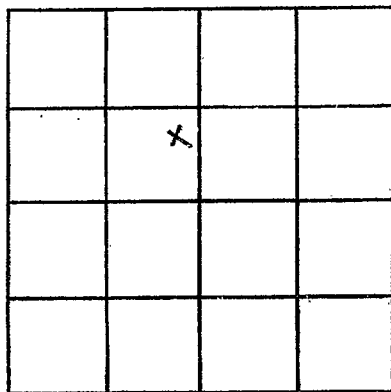

SECTION 3

Please indicate well location X.

ADDITIONAL INFORMATION

Lined area for additional information.

If more than one screen, show locations of each on sketch.