

TATE  
K7  
9-15-71

MISSISSIPPI  
BOARD OF WATER COMMISSIONERS  
416 North State Street  
Jackson, Mississippi 39201

DEC 8 1971

CODED

WATER WELL DRILLERS LOG

9-15 1971 Harris Bros. Tate  
date well completed firm name county well located

LANDOWNER: Tommy Dabbs  
Pt. 3  
Senatobia  
(mailing address)

description of formations encountered	from	to
top soil	0	20
gray clay	20	125
clay + sand	125	180
Coarse sand	180	200

WELL LOCATION:  
sec. 1 T. 6 N. R. 9 E.  
1 miles S of Pinwood  
(distance) (direction) (nearest town)

WELL PURPOSE: home  
(home, irrigation, municipal, industrial)

- WELL COMPLETION DATA:
- (1) diameter (inches) 4
  - (2) total depth (feet) 200
  - (3) static water level (feet) 80 <sup>below</sup> top of ground.
  - (4) casing (material) Plastic, (depth) 186
  - 4 (size) if telescope see back.
  - (5) screen (length) 14, (depth to top) 186
  - 008 (size) Plastic (material)
  - (6) pump 3/4 (HP), 10 (yfeld gpm)
  - elec. (type power)
  - (7) electric log No (yes or no)

CODED


(organization running log)

(8) how well bottom plugged with shot

DRILLERS REMARKS:

If well telescopes please sketch and show depths.

GROUND LEVEL

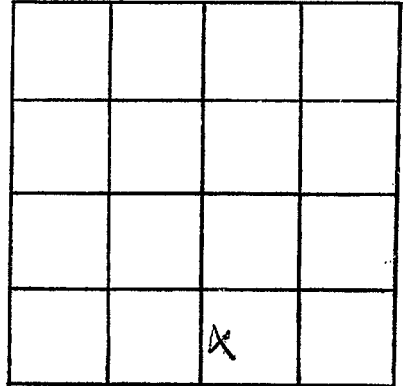

SECTION 1

Please indicate well location X.

ADDITIONAL INFORMATION

If more than one screen,  
show locations of each on sketch.