

CODED

TATE
K8
1-28-72

MISSISSIPPI
BOARD OF WATER COMMISSIONERS
416 North State Street
Jackson, Mississippi 39201

FEB 22 1972

WATER WELL DRILLERS LOG


1-28 date well completed 1972 firm name Shelby Newman Tate county well located Tate

LANDOWNER:	description of formations encountered	from	to
Albert F Campbell P.O. Box 109 Senatobia Miss (mailing address)	Red clay	0	30
	Sand & gravel	30	80
	Mixture of white clay & sand	80	120
	Clear white sand	120	130
<p>WELL LOCATION: sec. 1 T. 6 R. 9 8 miles W of Senatobia (distance) (direction) (nearest town)</p>			
<p>WELL PURPOSE: Home (home, irrigation, municipal, industrial)</p>			
<p>WELL COMPLETION DATA:</p>			
(1) diameter (inches) 4			
(2) total depth (feet) 130			
(3) static water level (feet) 38 below above top of ground.			
(4) casing Plastic, 130 (material) (depth)			
(size) if telescope see back.			
(5) screen 10ft (length) (depth to top)			
4in Plastic (size) (material)			
(6) pump 3/4 (HP) 25 (yield gpm)			
Electric (type power)			
(7) electric log no (yes or no)			
(organization running log)			
(8) how well bottom plugged 4in Plastic Cap			
DRILLERS REMARKS:			

CODED

If well telescopes please sketch and show depths.

GROUND LEVEL

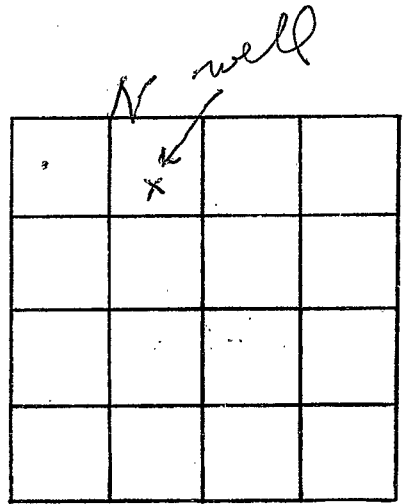

SECTION 1

Please indicate well location X.

ADDITIONAL INFORMATION

If more than one screen,
show locations of each on sketch.