

TATE
K9
5-15-72

MISSISSIPPI
BOARD OF WATER COMMISSIONERS
416 North State Street
Jackson, Mississippi 39201

WATER WELL DRILLERS LOG

CODED
Tate

May 15 1972 Shelby Newman
date well completed firm name county well located

LANDOWNER:	description of formations encountered	from	to
JAMES RHOADES a. J. Young	Dark clay	0	20
Senatobia Miss. (mailing address)	white clay	20	35
WELL LOCATION: sec. 1 T. 6 N. R. 9 E. S W	White Sand	35	40
10 miles W of Senatobia (distance) (direction) (nearest town)			

WELL PURPOSE: Home
(home, irrigation, municipal, industrial)

- WELL COMPLETION DATA:
- (1) diameter (inches) 4
 - (2) total depth (feet) 70
 - (3) static water level (feet) 40 below top of ground.
 - (4) casing Plastic, 70 (material) (depth)
 - (size) If telescope see back.
 - (5) screen 10 ft. (length) (depth to top)
4 Plastic (size) (material)
 - (6) pump 3/4 (HP) 30 (yield gpm)
Electric (type power)
 - (7) electric log no (yes or no)
no (organization running log)
 - (8) how well bottom plugged 4 in cap

CODED


MAY 11 1972

MISS. SD. OF
WATER BOARD

DRILLERS REMARKS:

If well telescopes please sketch and show depths.

GROUND LEVEL

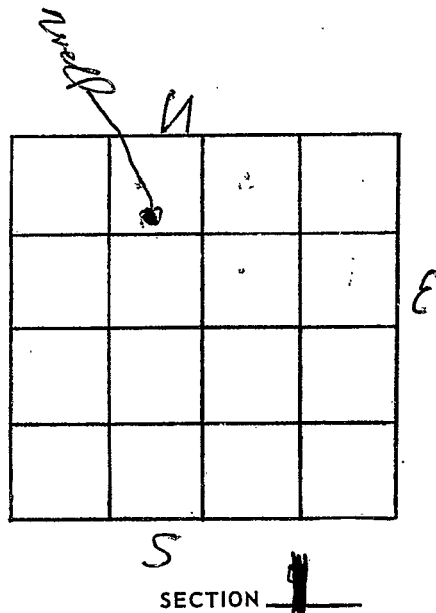

Please indicate well location X.

ADDITIONAL INFORMATION

If more than one screen,
show locations of each on sketch.