

TATE  
K10  
6-24-72

MISSISSIPPI  
BOARD OF WATER COMMISSIONERS  
416 North State Street  
Jackson, Mississippi 39201

WATER WELL DRILLERS LOG

6-24 date well completed 19 72 Shelby Neyman firm name Tate county well located

LANDOWNER: Dr. H. Bell  
Circle M Angus Ranch  
Sarah Min  
(mailing address)

description of formations encountered	from	to
Red clay	0	30
Blue clay	30	110
White Sand	110	140

WELL LOCATION:  
sec. 9 T. 6 N. R. 9 E  
3 miles S of Strayhorn  
(distance) (direction) (nearest town)

WELL PURPOSE: Swine Farm  
(home, irrigation, municipal, industrial)

- WELL COMPLETION DATA:
- (1) diameter (inches) 4
  - (2) total depth (feet) 140
  - (3) static water level (feet) 22 below top of ground.
  - (4) casing Plastic, 140,  
(material) (depth)  
If telescope see back.  
(size)
  - (5) screen 20,  
(length) (depth to top)  
4 in., Plastic  
(size) (material)
  - (6) pump 1 30  
(HP) (yield gpm)  
Electric  
(type power)
  - (7) electric log no  
(yes or no)  
VC  
(organization running log)
  - (8) how well bottom plugged Plastic cap


DRILLERS REMARKS:

JUL 17 1972

SEAL  
MINUTE  
MINUTE  
MINUTE

If well telescopes please sketch and show depths.

GROUND LEVEL

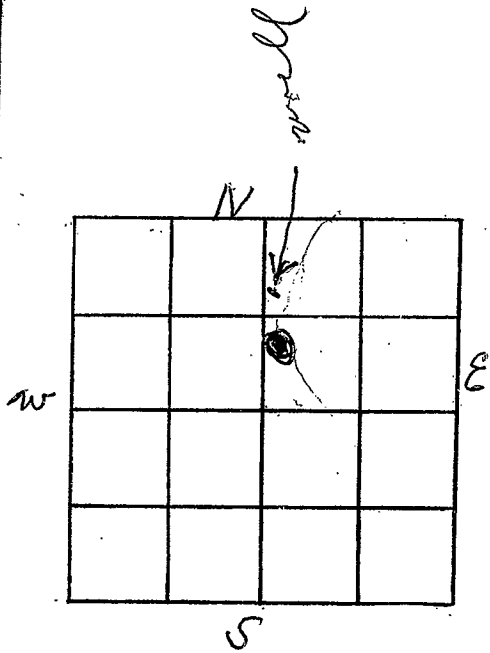

SECTION 9

Please indicate well location X.

ADDITIONAL INFORMATION

If more than one screen, show locations of each on sketch.