

MISSISSIPPI  
BOARD OF WATER COMMISSIONERS  
416 North State Street  
Jackson, Mississippi 39201

**CODED**

TATE  
K 11  
10-25-72

WATER WELL DRILLERS LOG

10-25-1972 Bob Smith Tate  
date well completed firm name county well located

LANDOWNER:  
Wallace Buchanan  
Senatobia, Miss.  
(mailing address)

description of formations encountered	from	to
<u>clay lint</u>		<u>10</u>
<u>yellow clay</u>	<u>10</u>	<u>20</u>

WELL LOCATION:  
sec. 5 T. 6 N. R. 9 E  
2 3/4 miles SW of Strayhorn  
(distance) (direction) (nearest town)

<u>gumbo</u>	<u>20</u>	<u>272</u>
<u>coarse gray sand</u>	<u>272</u>	<u>302</u>

WELL PURPOSE: Home  
(home, irrigation, municipal, industrial)

- WELL COMPLETION DATA:
- (1) diameter (inches) 4
  - (2) total depth (feet) 302
  - (3) static water level (feet) 90 below above top of ground.
  - (4) casing Plastic 302  
(material) (depth)  
(size) if telescope see back.
  - (5) screen 20 282  
(length) (depth to top)  
4 Plastic  
(size) (material)
  - (6) pump 1/2 10  
(HP) (yield gpm)  
Electric  
(type power)
  - (7) electric log no  
(yes or no)  
(organization running log)
  - (8) how well bottom plugged plugged



**CODED**

FEB 26 1973

DRILLERS REMARKS:

If well telescopes please sketch and show depths.

GROUND LEVEL

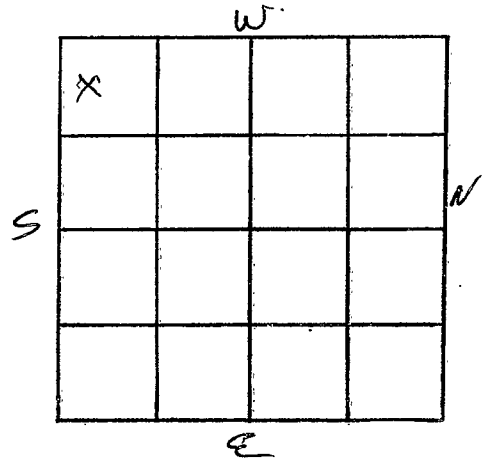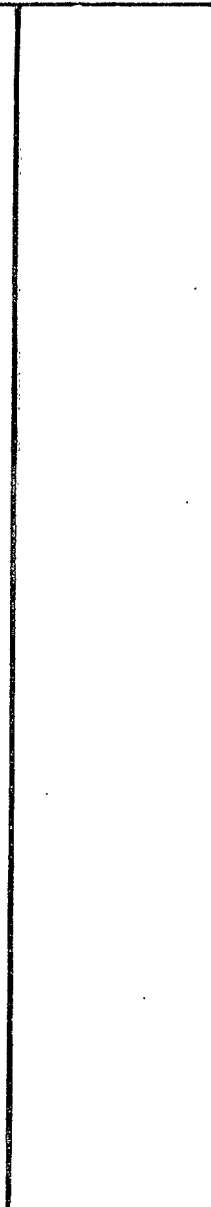

SECTION 5

Please indicate well location X.

ADDITIONAL INFORMATION

*Thin Rock at 215*

If more than one screen, show locations of each on sketch.