

**LATE**  
**K 12**  
**9-18-73**

MISSISSIPPI  
BOARD OF WATER COMMISSIONERS  
416 North State Street  
Jackson, Mississippi 39201

**WATER WELL DRILLERS LOG**

9-18 date well completed      1973      Harris Bros. firm name      Late county well located

LANDOWNER: <u>Clyde Liske</u>	description of formations encountered	from	to
<u>Pt. 2</u>	<u>top soil</u>	<u>0</u>	<u>20</u>
<u>Senatobia</u> (mailing address)	<u>red sand</u>	<u>20</u>	<u>45</u>
WELL LOCATION: sec <u>2</u> T <u>6</u> N R <u>9</u> E	<u>gray clay</u>	<u>4.5</u>	<u>215</u>
<u>2</u> miles <u>S</u> of <u>Strayhorn</u> (distance) (direction) (nearest town)	<u>fine sand &amp; clay</u>	<u>215</u>	<u>310</u>
WELL PURPOSE: <u>None</u> (home, irrigation, municipal, industrial)	<u>Coarse sand</u>	<u>310</u>	<u>330</u>
WELL COMPLETION DATA:			
(1) diameter (inches) <u>4</u>			
(2) total depth (feet) <u>330</u>			
(3) static water level (feet) <u>120</u> <small>below/above top of ground.</small>			
(4) casing <u>Plastic</u> <u>316</u> (material) (depth)			
<u>4</u> if telescope see back. (size)			
(5) screen <u>14</u> <u>316</u> (length) (depth to top)			
<u>008</u> <u>Plastic</u> (size) (material)			
(6) pump <u>3/4</u> <u>7</u> (HP) (y.feld gpm)			
<u>etc.</u> (type power)			
(7) electric log <u>NO</u> (yes or no)			
(organization running log)			
(8) how well bottom plugged <u>solid</u>			
DRILLERS REMARKS:			


**CODED**

NOV 25 1973

MISS. BO. OF WATER COMMISSIONERS

If well telescopes please sketch and show depths.

GROUND LEVEL

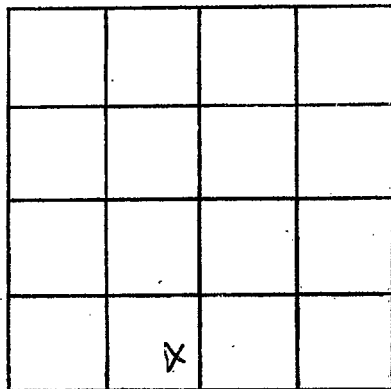

SECTION 2

Please indicate well location X.

ADDITIONAL INFORMATION

If more than one screen, show locations of each on sketch.