

TATE
K 14
4-10-79

MISSISSIPPI
BOARD OF WATER COMMISSIONERS
416 North State Street
Jackson, Mississippi 39201

CODED

WATER WELL DRILLERS LOG

4-10 19 74 Bob Smith + Son Tate
date well completed firm name county well located

LANDOWNER:	description of formations encountered	from	to
Ray Williams Stryker Sokal, Miss (mailing address)			
WELL LOCATION:	Red clay	5'	40'
sec. 3 T 6 N R 9 E 5 miles S of Stryker (distance) (direction) (nearest town)	Blue clay	40'	160'
WELL PURPOSE: (home, irrigation, municipal, industrial)	White sand	160'	205'
WELL COMPLETION DATA:			
(1) diameter (inches) 4			
(2) total depth (feet) 205			
(3) static water level (feet) _____ below top of ground.			
(4) casing Plastic 205 (material) (depth)			
(size) if telescope see back.			
(5) screen 10 195 (length) (depth to top)			
4 Plastic (size) (material)			
(6) pump 1/2 10 (HP) (yield gpm)			
Elec. (type power)			
(7) electric log No. (yes or no)			
(organization running log)			
(8) how well bottom plugged plugged			
DRILLERS REMARKS:			


CODED

MISSISSIPPI BOARD OF WATER COMMISSIONERS
JUN 24 1974

MISS. Bd. of Water Comm.

If well telescopes please sketch and show depths.

GROUND LEVEL

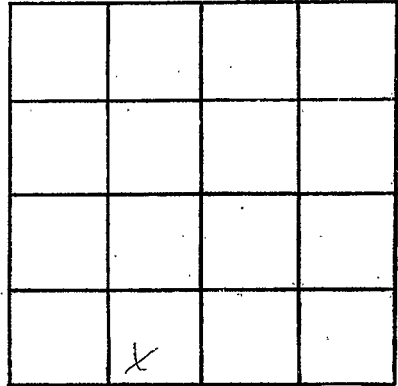

SECTION 3

Please indicate well location X.

ADDITIONAL INFORMATION

If more than one screen, show locations of each on sketch.