

MISSISSIPPI
BOARD OF WATER COMMISSIONERS
416 North State Street
Jackson, Mississippi 39201

CODED

WATER WELL DRILLERS LOG

TATE
K 15
8-12-74

8-12
date well completed

1974

Harris Bros
firm name

Zate
county well located

LANDOWNER: L. W. Lynn
Rt. 1
Strayhorn
(mailing address)


description of formations encountered	from	to
top soil	0	20
white clay	20	50
gray clay	50	160
fine sand	160	210
coarse sand	210	230

WELL LOCATION:
sec. 5 T. 6 N. R. 9 E ^{BE}
2 1/4 miles SW of Strayhorn
(distance) (direction) (nearest town)

WELL PURPOSE: home
(home, irrigation, municipal, industrial)

WELL COMPLETION DATA:
(1) diameter (inches) 4
(2) total depth (feet) 230
(3) static water level (feet) 100 (below above top of ground.)
(4) casing Plastic, 216
(material) (depth)
4 If telescope see back.
(size)
(5) screen 14, 216
(length) (depth to top)
408, Plastic
(size) (material)
(6) pump 3/4, 10
(HP) (yield gpm)
elec.
(type power)
(7) electric log no
(yes or no)
(organization running log)
(8) how well bottom plugged solid

CODE

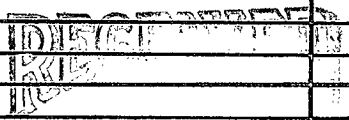


MAR 17 1975

DRILLERS REMARKS:

If well telescopes please sketch and show depths.

GROUND LEVEL

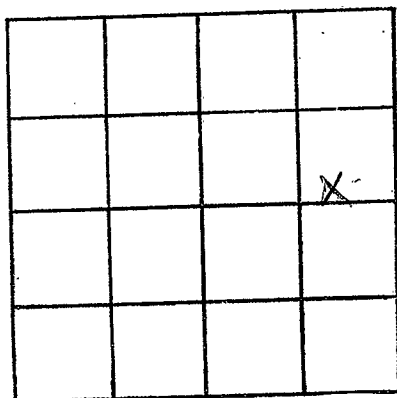

SECTION 5

Please indicate well location X.

ADDITIONAL INFORMATION

If more than one screen,
show locations of each on sketch.