

MISSISSIPPI DEPARTMENT OF NATURAL RESOURCES

Bureau of Land and Water Resources

Southport Mall

P.O. Box 10631

CODED

Jackson, Mississippi 39209

WATER WELL DRILLERS LOG

TATE
K16
6-21-84

HICKS WELL CO.
Pt. 1, Box 157
Senatobia, MS 38668

Tate
county well located

6/21 1984
date well completed

LANDOWNER	description of formations encountered	from	to
Hambers Peach Farm Rt. 2	Red Clay	0	10
Senatobia Ms. 38668 (mailing address)	Red Sand	10	60
WELL LOCATION: sec. 2 T 6 N R 9 E 2 miles S of Strongham	White Sand	60	155
(distance) (direction) (nearest town)	Black + White Clay	155	210
WELL PURPOSE: Farm (home, irrigation, municipal, industrial)	White Sand	210	230

WELL COMPLETION DATA:

- (1) diameter (inches) 4
- (2) total depth (feet) 230
- (3) static water level (feet) 150 below above top of ground.
- (4) casing PVC, 230' (material) (depth)
- 4 (size) If telescope see back.
- (5) screen 10, 220' (length) (depth to top)
- 10 1/2 (size) PVC (material)
- (6) pump 3, 35 (HP) (yield gpm)
- 220 V (type power)
- (7) electric log NO (yes or no)

(organization running log)


(8) how well bottom plugged cap

DRILLERS REMARKS:

DEPT. OF NATURAL RESOURCES
BUREAU OF LAND & WATER RESOURCES
JUL 10 1984
RECEIVED

If well telescopes please sketch and show depths.

GROUND LEVEL

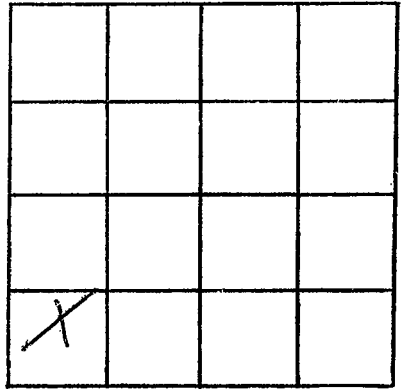

SECTION 2

Please indicate well location X.

ADDITIONAL INFORMATION

If more than one screen, show locations of each on sketch.