

MISSISSIPPI BOARD OF WATER COMMISSIONERS

WATER WELL DRILLERS LOG

Tate
K 2000
9-66

Date: Sept 16, 1966, Driller: Shelby Newman County Tate
(Name)

(1) Owner of Land:	Description & Color of Materials Sand, Clay, Red Clay, Shell, etc.	Thick- ness Feet	Depth Feet
<u>Harold Burk</u> (Name) <u>Senatobia Miss R 2</u> (Address) <u>SE SW 1 T 6 R 9</u> SE 1/4, SW 1/4, Sec. 1 T 6 R 9	<u>Red Clay</u>	<u>30</u>	<u>30</u>
<u>3</u> miles <u>SE</u> of <u>Strayhorn</u> (distance) (direction) (Nearest Town)	<u>Red Sand & gravel</u>	<u>40</u>	<u>70</u>
(3) Topography: <u>Hilly</u> (Hilly) (Flat) (Level)	<u>white clay</u>	<u>8</u>	<u>78</u>
(4) Purpose of Well: <u>Domestic</u> (Domestic Irrigation Municipal, Industrial, Other)	<u>Mixture white clay to sand</u>	<u>60</u>	<u>138</u>


Information upon completion of well:

- (1) Diameter 2 inches.
- (2) Total Depth 154 feet.
- (3) Water Level 92 feet below top of ground.
- (4) Cased to 147, Size 2 in.
- (5) Screen: Size 90, Length 6 ft.
- (6) Were any formations sealed against pollution?
_____ yes, No no.

If YES depth of formation _____
Why _____

Drillers Remarks: _____

white sand 16 154

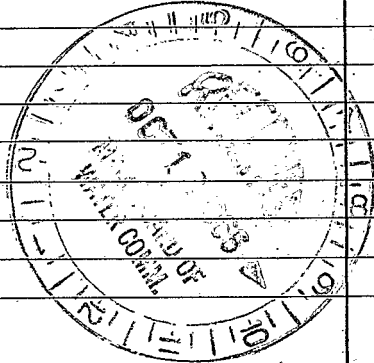

(Use Back Side)

Well No.

1

1. The first part of the document discusses the importance of maintaining accurate records of all transactions and activities. It emphasizes the need for transparency and accountability in financial reporting.

2. The second part of the document outlines the various methods and techniques used to collect and analyze data. It includes a detailed description of the experimental procedures and the instruments used.

3. The third part of the document presents the results of the experiments and discusses the implications of the findings. It compares the experimental results with theoretical predictions and previous studies.

4. The fourth part of the document concludes the study and provides a summary of the key findings. It also discusses the limitations of the study and suggests areas for future research.

5. The fifth part of the document contains a list of references and a list of figures. The references include books, articles, and other sources used in the study.

6. The sixth part of the document contains a list of figures and tables. Each figure is accompanied by a caption and a description of the data it represents.

7. The seventh part of the document contains a list of tables and figures. Each table is accompanied by a caption and a description of the data it represents.

8. The eighth part of the document contains a list of tables and figures. Each table is accompanied by a caption and a description of the data it represents.

9. The ninth part of the document contains a list of tables and figures. Each table is accompanied by a caption and a description of the data it represents.