

Late
K 200
9-29-76

MISSISSIPPI
BOARD OF WATER COMMISSIONERS
416 North State Street
Jackson, Mississippi 39201

WATER WELL DRILLERS LOG

9-29 1976 ^{15E} Hicks Well Co. Late
date well completed firm name county well located

LANDOWNER: James Rhodes
Rt. 2
Senatobia, Miss.
(mailing address)

description of formations encountered	from	to
Red clay	0	30
Red + Blue clay	30	95
White Sand	95	130

WELL LOCATION:
sec. 2 T. 6 N. R. 9 E
2 1/2 miles SE of Crockett
(distance) (direction) (nearest town)

WELL PURPOSE: Domestic
(home, irrigation, municipal, industrial)

- WELL COMPLETION DATA:
- (1) diameter (inches) 4
 - (2) total depth (feet) 130
 - (3) static water level (feet) 75 below top of ground
 - (4) casing PVC, 130 (material) (depth)
 - (size) if telescope see back.
 - (5) screen 4 ft, 126 (length) (depth to top)
 - 4" (size) (material)
 - (6) pump 3/4 HP, 10 (yield gpm)
 - 220V (type power)
 - (7) electric log No (yes or no)
 - (organization running log)
 - (8) how well bottom plugged Cap


DRILLERS REMARKS:

RECEIVED
JAN 5 1977

MISS. BD. OF WATER COMMISSIONERS

If well telescopes please sketch and show depths.

GROUND LEVEL

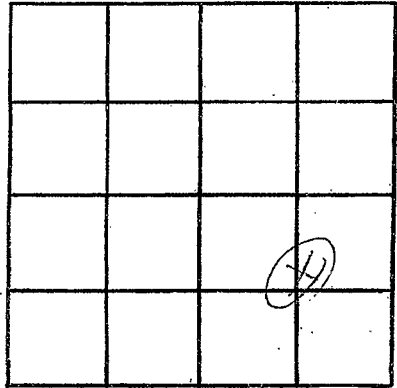

SECTION 2

Please indicate well location X.

ADDITIONAL INFORMATION

If more than one screen,
show locations of each on sketch.