

Date  
 K ~~2000~~  
 9-30-76

MISSISSIPPI  
 BOARD OF WATER COMMISSIONERS  
 416 North State Street  
 Jackson, Mississippi 39201

WATER WELL DRILLERS LOG

9-30 1976 <sup>15E</sup> Heiskell Well Co. Tate  
 date well completed firm name county well located

LANDOWNER: Cypress Corners Church  
Rt. 1,  
Senatobia, Miss.  
 (mailing address)

description of formations encountered	from	to
Red Sand	0	40
Gravel + sand	40	95
White clay + sand	95	180
White sand	180	235
clay	235	240

WELL LOCATION:  
 sec. 16 T. 6 N. R. 9 E.  
3 1/2 miles S of Proctor  
 (distance) (direction) (nearest town)

WELL PURPOSE: church  
 (home, irrigation, municipal, industrial)

WELL COMPLETION DATA:

(1) diameter (inches) 4

(2) total depth (feet) 240

(3) static water level (feet) 130 below above top of ground.

(4) casing PVC 240  
 (material) (depth)  
 (size) if telescope see back.

(5) screen 11 199  
 (length) (depth to top)  
4" Gravel  
 (size) (material)

(6) pump 3/4 10  
 (HP) (yield gpm)  
220V  
 (type power)

(7) electric log No  
 (yes or no)

(organization running log)

(8) how well bottom plugged Gravel  
and sand


DRILLERS REMARKS:

RECEIVED  
 JAN 5 1977

MISS. BD. OF WATER COMMISSIONERS

If well telescopes please sketch and show depths.

GROUND LEVEL

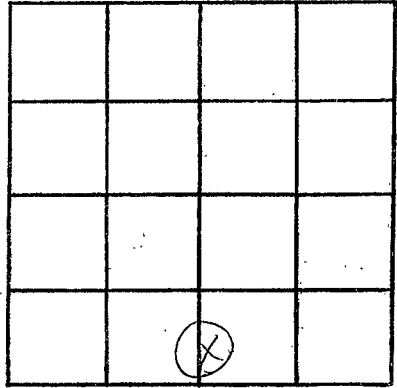

SECTION 16

Please indicate well location X.

ADDITIONAL INFORMATION

If more than one screen,  
show locations of each on sketch.