

TATE
K 2004
3-28-79

MISSISSIPPI
BOARD OF WATER COMMISSIONERS
416 North State Street
Jackson, Mississippi 39201

WATER WELL DRILLERS LOG

3-1-79 date well completed
Hicks well co firm name
TATE county well located

LANDOWNER:
Ine Mcpart
Rt. 2 Senatobia Miss.
(mailing address)

description of formations encountered	from	to
Red Clay	0	10
Clay + sand	10	80
White sand	80	105

WELL LOCATION:
sec. 1 T 6 N R 9 E
(distance) miles (direction) of (nearest town)

WELL PURPOSE: Home
(home, irrigation, municipal, industrial)

- WELL COMPLETION DATA:
- (1) diameter (inches) 4 in.
 - (2) total depth (feet) 105
 - (3) static water level (feet) 60 below above top of ground.
 - (4) casing Plastic, 105 (material) (depth)
 - (size) If telescope see back.
 - (5) screen 7 ft, 98 ft. (length) (depth to top)
4 in. gravel (size) (material)
 - (6) pump 1/2 (HP) 10 (yield gpm)
220 (type power)
 - (7) electric log NO (yes or no)


(organization running log)
(8) how well bottom plugged Cap

DRILLERS REMARKS:

Miss. Board of Water Comm.
MAR 22 1979
RECEIVED

If well telescopes please sketch and show depths.

GROUND LEVEL

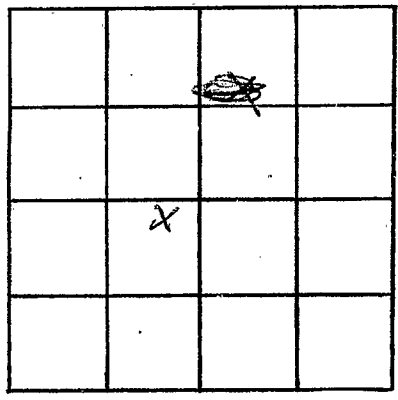

SECTION 1

Please indicate well location X.

ADDITIONAL INFORMATION

Lined area for additional information.

If more than one screen, show locations of each on sketch.