

MISSISSIPPI DEPARTMENT OF NATURAL RESOURCES

Bureau of Land and Water Resources

P.O. Box 10631

Jackson, Mississippi 39209

WATER WELL DRILLERS LOG

COUNTY WELL LOCATED <i>Greene</i>	
WELL NUMBER <i>R2007</i>	CODED
DATE WELL COMPLETED <i>9-10-86</i>	

PERMIT NUMBER
NAME OF DRILLING FIRM <i>Wicks Well Co.</i>

NAME & MAILING ADDRESS OF LANDOWNER <i>A. A. Stinson</i>		
<i>Comile St.</i>		
<i>Demotable MS 38612</i>		
WELL LOCATION: SEC	TOWNSHIP	RANGE
<i>2</i>	<i>6</i>	<i>9</i>
	N S	E W
DISTANCE	DIRECTION	NEAREST TOWN
<i>3</i> Miles	<i>SE</i>	<i>Stegham</i>
OTHER LANDMARK		
WELL PURPOSE: <input checked="" type="checkbox"/> Home Irrigation, Municipal, Industrial, Fish Pond, etc.		

PUMP DATA		
PUMP TYPE (Circle One): <input checked="" type="checkbox"/> Submersible, Turbine, Jet, Flowing Well, Other (Describe) _____		
POWER TYPE (Circle One): <input checked="" type="checkbox"/> Electric, Tractor, Diesel, Gasoline, Butane, Other (Describe) _____		
Pump Capacity (GPM)	No. of Stages	Setting Depth
<i>10</i>	<i>7</i>	<i>240</i> FT.
PUMP TEST		
Well yielded _____ <i>10</i> GPM with a drawdown of _____ ft. after _____ hours of pumping		

WELL DATA		
Well Depth <i>275'</i>	Casing Diameter (In.) <i>4"</i>	Casing Length (Ft.) <i>265'</i>
Type of Casing <i>PVC</i>	Hole Depth <i>275'</i>	Depth to Static Water Level <i>200'</i>
TYPE OF COMPLETION: (Circle One or More): <input checked="" type="checkbox"/> Gravel Packed, Underreamed, Telescoped, Natural Development, Open Hole, Other		
Top of Lap Pipe or Reduction in Casing		
FEET <input type="checkbox"/> IF TELESCOPED OR MORE THAN ONE SCREEN: USE BACK PAGE		

LOG DATA	
TYPE OF LOG RUN (Circle One): No Log Run, Electric, Gamma Ray, Density, Sonic, Neutron, Other (Describe) _____	
Name of Organization Running Log	

SCREEN DATA		
Diameter - Inches <i>4"</i>	Length - Feet <i>10'</i>	Slot Size - Inches <i>.013</i>
Screen Type <i>PVC</i>	Depth to Bottom - Feet <i>10'</i>	

GEOLOGIC DATA (Office Use Only)			
Surface Elev.	Geologic Unit	Unit Thickness	Depth to Top
Subs. SWL	Date	Analysis	Aquifer Test

Driller's Remarks

RECEIVED

DESCRIPTION OF FORMATIONS ENCOUNTERED	FROM	TO	FORMATIONS (Continued)	
			FROM	TO
<i>Red clay</i>	<i>0</i>	<i>10</i>		
<i>Clay</i>	<i>10</i>	<i>110</i>		
<i>White sand</i>	<i>110</i>	<i>135</i>		
<i>Black clay</i>	<i>135</i>	<i>245</i>		
<i>White sand</i>	<i>245</i>	<i>275</i>		


OCT 29 1986

Department of Natural Resources
Bureau of Land & Water Resources

IF MORE SPACE IS NEEDED, USE BACK

If well telescopes please sketch and show depths.

GROUND LEVEL

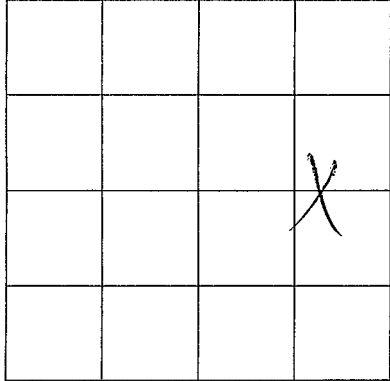

SECTION 2

Please indicate well location X.

ADDITIONAL INFORMATION

Lined area for additional information.

If more than one screen, show location of each on sketch.