

MISSISSIPPI DEPARTMENT OF NATURAL RESOURCES

Bureau of Land and Water Resources

P.O. Box 10631

Jackson, Mississippi 39209

WATER WELL DRILLERS LOG

COUNTY WELL LOCATED TATE	
WELL NUMBER K	CODED
DATE WELL COMPLETED 2-2-90	

PERMITS HICKS WELL CO.
NAME OF DRILLING FIRM RT-1 BOX 157 SENATOBIA, MS 38668

NAME & MAILING ADDRESS OF LANDOWNER Bob Meucci		
Rt. 2 Box 117m		
Senatobia, ms 38668		
WELL LOCATION:	SEC	TOWNSHIP RANGE
	13	6 N 9 W
DISTANCE	DIRECTION	NEAREST TOWN
8 Miles	S/E	of Senatobia
OTHER LANDMARK		
WELL PURPOSE: <input checked="" type="checkbox"/> Home Irrigation, <input type="checkbox"/> Municipal, <input type="checkbox"/> Industrial, <input type="checkbox"/> Fish Pond, etc.		

PUMP DATA		
PUMP TYPE (Circle One): <input checked="" type="checkbox"/> Submersible Turbine, Jet Flowing Well, Other (Describe) _____		
POWER TYPE (Circle One): <input checked="" type="checkbox"/> Electric, Tractor, Diesel, Gasoline, Butane, Other (Describe) _____ H/P 1		
Pump Capacity (GPM)	No. of Stages	Setting Depth
18	12	140 FT.
PUMP TEST		
Well yielded _____ GPM with a drawdown of _____ ft. after _____ hours of pumping		

WELL DATA		
Well Depth	Casing Diameter (In.)	Casing Length (Ft.)
220	PVC	205
Type of Casing	Hole Depth	Depth to Static Water Level
PVC	220	138
TYPE OF COMPLETION: (Circle One or More): <input checked="" type="checkbox"/> Gravel Packed, <input type="checkbox"/> Underreamed, <input type="checkbox"/> Telescoped, <input type="checkbox"/> Natural Development, <input type="checkbox"/> Open Hole, <input type="checkbox"/> Other (Describe) _____		
Top of Lap Pipe or Reduction in Casing		
FEET	IF TELESCOPED OR MORE THAN ONE SCREEN: USE BACK PAGE	

LOG DATA	
TYPE OF LOG RUN (Circle One): No Log Run, Electric, Gamma Ray, Density, Sonic, Neutron, Other (Describe) _____	
Name of Organization Running Log	

SCREEN DATA		
Diameter - Inches	Length - Feet	Slot Size - Inches
4"	15'	013
Screen Type	Depth to Bottom - Feet	
PVC	15'	


GEOLOGIC DATA (Office Use Only)			
Surface Elev.	Geologic Unit	Unit Thickness	Depth to Top
Subs. SWL	Date	Analysis	Aquifer Test
Driller's Remarks			

DESCRIPTION OF FORMATIONS ENCOUNTERED	FROM	TO	FORMATIONS (Continued)	FROM	TO
PC	0	20	<div style="font-size: 2em; font-weight: bold; opacity: 0.5;">DISCOVERED</div> <div style="font-size: 1.5em; font-weight: bold; margin-top: 10px;">FEB 13 1990</div> <div style="font-size: 0.8em; margin-top: 10px;"> Department of Natural Resources Bureau of Land & Water Resources </div>		
RC & S	20	60			
CLAY	60	140			
CLAY & S	140	180			
WS	180	220			

IF MORE SPACE IS NEEDED, USE BACK

If well telescopes please
sketch and show depths.

GROUND LEVEL

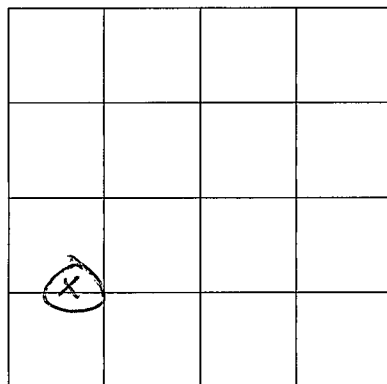

SECTION _____

Please indicate well location X.

ADDITIONAL INFORMATION

If more than one screen,
show location of each on sketch.