

MISSISSIPPI DEPARTMENT OF ENVIRONMENTAL QUALITY
Office of Land and Water Resources

P. O. Box 10631
Jackson, MS 39289-0631
WATER WELL DRILLERS LOG

COUNTY WELL LOCATED TATE	
WELL NUMBER 32	CODED
K 2022	
DATE WELL COMPLETED 6-16-99	

PERMIT NUMBER
NAME OF DRILLING FIRM SMITH WELLS DRILLING SERVICE

NAME & MAILING ADDRESS OF LANDOWNER PASEUR, ED		
BROWN FERRY RD.		
GENAOBIA		
WELL LOCATION: SEC	TOWNSHIP	RANGE
K-8	T-60	R-90
DISTANCE	DIRECTION	NEAREST TOWN
_____ Miles	_____ of	_____
OTHER LANDMARK		
WELL PURPOSE: Home, Irrigation, Municipal, Industrial, Fish Pond, etc.		

PUMP DATA		
PUMP TYPE (Circle One): Submersible , Turbine, Jet, Flowing Well, Other (Describe) _____		
POWER TYPE (Circle One): Electric , Tractor, Diesel, Gasoline, Butane, Other (Describe) _____ H/P 34		
Pump Capacity (GPM) 12	No. of Stages 10	Setting Depth 60 FT.
PUMP TEST		
Well yielded 12 GPM with a drawdown of 4 ft. after 2 hours of pumping		

WELL DATA		
Well Depth 300'	Casing Diameter (In.) 4"	Casing Length (Ft.) 280'
Type of Casing PVC	Hole Depth 300'	Depth to Static Water Level 50'
TYPE OF COMPLETION: (Circle One or More): Gravel Packed, Underreamed, Telescoped, Natural Development, Open Hole, Other (Describe) WASHED SAND		
WELL GROUTED TO A DEPTH OF 10 FEET Type Grout (circle one): Cement, Bentonite, or Mix		

LOG DATA	
TYPE OF LOG RUN (Circle One): Electric , Gamma Ray, Density, Sonic, Neutron, Other (Describe) _____	
Name of Organization Running Log	

SCREEN DATA		
Diameter - Inches 4"	Length - Feet 20'	Slot Size - Inches 14 TAPS.
Screen Type PVC	Depth to Bottom - Feet 300'	

GEOLOGIC DATA (Office Use Only)			
Surface Elev.	Geologic Unit	Unit Thickness	Depth to Top
Subs. SWL	Date	Analysis	Aquifer Test

Driller's Remarks
Top of Lap Pipe or Reduction in Casing
FEET IF TELESCOPED OR MORE THAN ONE SCREEN: USE BACK PAGE


DESCRIPTION OF FORMATIONS ENCOUNTERED	FROM	TO
TOP SOIL	0	10
SAND + GRAVEL	10	30
Grey CLAY	30	270
WHITE SAND	270	300

Dept. of Environmental Quality
Office of Land & Water Resources

IF MORE SPACE IS NEEDED, USE BACK

If well telescopes please
sketch and show depths.

GROUND LEVEL

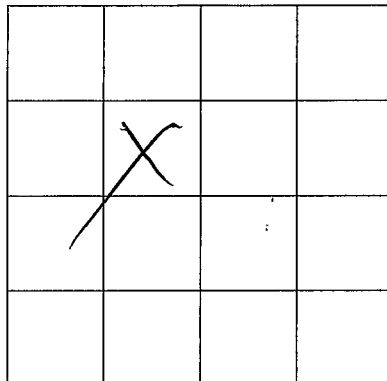

SECTION

K-8

Please indicate well location X.

ADDITIONAL INFORMATION

If more than one screen,
show location of each on sketch.