

TATE
L1
2-16-73

MISSISSIPPI
BOARD OF WATER COMMISSIONERS
416 North State Street
Jackson, Mississippi 39201

CODED

WATER WELL DRILLERS LOG

3-16-73 1973 Bob Smith Jate
date well completed firm name county well located

LANDOWNER:
Walter Boyd
Senatobia, Miss.
(mailing address)

description of formations encountered from to
Clay dirt 15

WELL LOCATION:
sec. 12 T. 6 N. R. 8 E.
4 1/2 miles SW of Senatobia
(distance) (direction) (nearest town)

gravel 15 42

white clay 42 50

red sand 50 60

sandy clay 60 125

WELL PURPOSE: None
(home, irrigation, municipal, industrial)

white clay 125 130

WELL COMPLETION DATA:

white sand 130 135

(1) diameter (inches) 4
(2) total depth (feet) 135

Gumbo 135 135

(3) static water level (feet) 66 below above top of ground.

(4) casing Plastic 135
(material) (depth)

(size) if telescope see back.

(5) screen 20 115
(length) (depth to top)

4 Plastic
(size) (material)

(6) pump 1/3 10
(HP) (yield gpm)

Electric
(type power)

(7) electric log no
(yes or no)

(organization running log)


(8) how well bottom plugged plugged

DRILLERS REMARKS:

APR 13 1973

If well telescopes please
sketch and show depths.

GROUND LEVEL

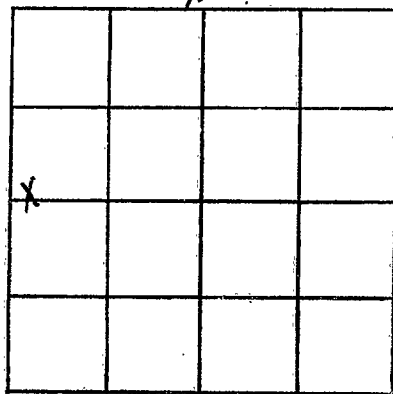

SECTION 12

Please indicate well location X.

ADDITIONAL INFORMATION

If more than one screen,
show locations of each on sketch.