

TATE  
L2  
7-10-73

MISSISSIPPI  
BOARD OF WATER COMMISSIONERS  
416 North State Street  
Jackson, Mississippi 39201

CODED

WATER WELL DRILLERS LOG

7-10 1973  
date well completed

Bob Smith  
firm name

Tate  
county well located

LANDOWNER:

Jane Collins  
Senatobia - Miss.  
(mailing address)

description of formations encountered

from 40 to 10

clay first

yellow clay

10 18

gravel

18 65

white clay

65 95

white sand

95 120

WELL LOCATION:

sec. 12 T 6 N R 8 E  
S W  
4 miles SW of Senatobia  
(distance) (direction) (nearest town)

WELL PURPOSE: Home  
(home, irrigation, municipal, industrial)

WELL COMPLETION DATA:

- (1) diameter (inches) 4
- (2) total depth (feet) 120
- (3) static water level (feet) 60 below top of ground.
- (4) casing Plastic 120  
(material) (depth)  
(size) If telescope see back.
- (5) screen 20 100  
(length) (depth to top)  
4 Plastic  
(size) (material)
- (6) pump 1/2 70  
(HP) (yield gpm)  
E.L.C.  
(type power)
- (7) electric log 70  
(yes or no)  
(organization running log)

CODED


(8) how well bottom plugged plugged

DRILLERS REMARKS:

SEP 27 1973

If well telescopes please sketch and show depths.

GROUND LEVEL

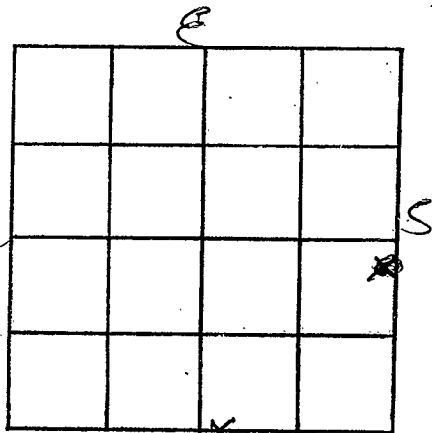

SECTION 12

Please indicate well location X.

ADDITIONAL INFORMATION

If more than one screen, show locations of each on sketch.