

TATE
L3
7-19-73

MISSISSIPPI
BOARD OF WATER COMMISSIONERS
416 North State Street
Jackson, Mississippi 39201

CODE

WATER WELL DRILLERS LOG

7-19-1973 date well completed Bob Smith firm name Tate county well located

LANDOWNER:

Charles Perry

Senatobia - Miss.
(mailing address)

WELL LOCATION:

sec. 12 6 N R 8 E
3 1/2 miles SW of Senatobia
(distance) (direction) (nearest town)

WELL PURPOSE: Home
(home, irrigation, municipal, industrial)

WELL COMPLETION DATA:

- (1) diameter (inches) 4
- (2) total depth (feet) 150
- (3) static water level (feet) 80 below top of ground.
- (4) casing Plastic 150
(material) (depth)
- (size) If telescope see back.
- (5) screen 30 130
(length) (depth to top)
- 4 Plastic
(size) (material)
- (6) pump 1/3 10
(HP) (yield gpm)
- Elec
(type power)
- (7) electric log 70
(yes or no)

(organization running log)

(8) how well bottom plugged plugged

DRILLERS REMARKS:

description of formations encountered

from to

clay silt	40	8
yellow clay	8	20
gravel	20	65
coarse sand		
gravel	65	105
white sand	105	150


CODED

SEP 27 1973

MISS. BD. OF
WATER COMM.

If well telescopes please sketch and show depths.

GROUND LEVEL

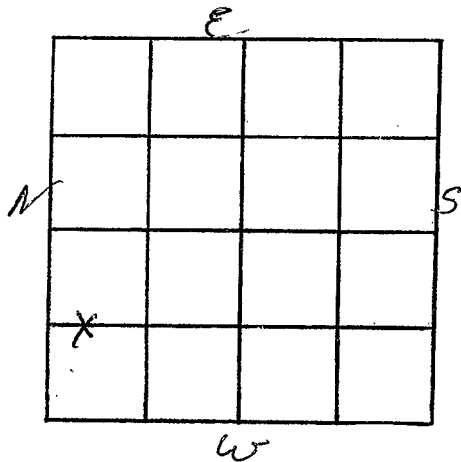

SECTION 12

Please indicate well location X.

ADDITIONAL INFORMATION

If more than one screen, show locations of each on sketch.