

TATE
L 4
7-25-73

MISSISSIPPI
BOARD OF WATER COMMISSIONERS
416 North State Street
Jackson, Mississippi 39201
WATER WELL DRILLERS LOG

CODED

Tate

7-25-1973 date well completed Bob Hill firm name Tate county well located

LANDOWNER:
Robert Dixon
Senatobia - miss.
(mailing address)

description of formations encountered	from	to
clay dirt	0	10
gravel	10	47
white sand	47	105

WELL LOCATION:
sec. 12 T 6 N R 8 E
3 1/4 miles S W of Senatobia
(distance) (direction) (nearest town)

WELL PURPOSE: Home
(home, irrigation, municipal, industrial)

WELL COMPLETION DATA:

(1) diameter (inches) 4

(2) total depth (feet) 105

(3) static water level (feet) 42 below top of ground.

(4) casing Plastic 105
(material) (depth)

(5) screen 20 85
(length) (depth to top)

4 Plastic
(size) (material)

(6) pump 1/2 10
(HP) (yield gpm)

E Lee
(type power)

(7) electric log 70
(yes or no)

(organization running log)

(8) how well bottom plugged plugged


CODE

DRILLERS REMARKS:

SEP 27 1973

If well telescopes please sketch and show depths.

GROUND LEVEL

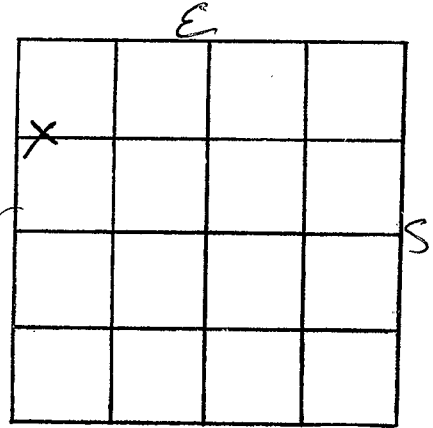

SECTION 12

Please indicate well location X.

ADDITIONAL INFORMATION

If more than one screen, show locations of each on sketch.