

TATE
L5
7-28-73

MISSISSIPPI
BOARD OF WATER COMMISSIONERS
416 North State Street
Jackson, Mississippi 39201

WATER WELL DRILLERS LOG

7-28-1973 date well completed Bob Tate firm name Tate county well located

LANDOWNER:	description of formations encountered	from	to
Chelved miles			
Sonatabia - miss. (mailing address)	Red Clay,	15	22
WELL LOCATION:	gravel	22	80
sec. 12 T 6 N R 8 E 3 3/4 miles SW of Sonatabia (distance) (direction) (nearest town)	white sand	80	133
WELL PURPOSE: Home (home, irrigation, municipal, industrial)			
WELL COMPLETION DATA:			
(1) diameter (inches) 4			
(2) total depth (feet) 133			
(3) static water level (feet) 95 below top of ground.			
(4) casing 4" white (material) 133 (depth)			
(size) if telescope see back.			
(5) screen 20" 113" (length) (depth to top)			
4" white (size) (material)			
(6) pump 1/2 (HP) 10 (yield gpm)			
Elec (type power)			
(7) electric log 70 (yes or no)			
(organization running log)			
(8) how well bottom plugged plugged			
DRILLERS REMARKS:			


CODED

SEP 27 1973

MISS. Bd. of WATER COMMISSIONERS

If well telescopes please sketch and show depths.

GROUND LEVEL

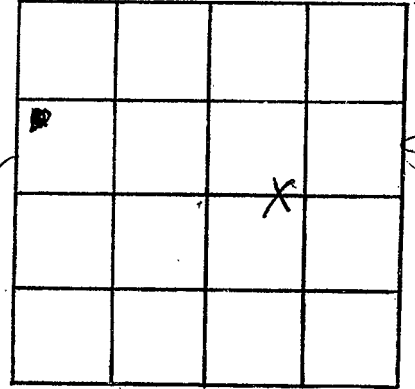

SECTION 12

Please indicate well location X.

ADDITIONAL INFORMATION

If more than one screen, show locations of each on sketch.