

TATE
L6
44-73

MISSISSIPPI
BOARD OF WATER COMMISSIONERS
416 North State Street
Jackson, Mississippi 39201
WATER WELL DRILLERS LOG

CODED

4-4 date well completed 23 Harris Bros. firm name Tate county well located

| LANDOWNER: | description of formations encountered | from | to |
|--|---------------------------------------|------|-----|
| William Johnson 3785 Northwind Dr. Memphis, Tennessee (mailing address) | | | |
| WELL LOCATION: sec. 8 T. 6 N. R. 8 E 8 1/2 miles SW of Senatobia (distance) (direction) (nearest town) | sand & gravel | 20 | 45 |
| WELL PURPOSE: <u>home</u> (home, irrigation, municipal, industrial) | sand & clay | 45 | 125 |
| WELL COMPLETION DATA: (1) diameter (inches) <u>4</u> (2) total depth (feet) <u>140</u> (3) static water level (feet) <u>80</u> ^{below} / _{above} top of ground. (4) casing <u>Plastic</u> , <u>133</u> (material) (depth) <u>4</u> If telescope see back. (size) (5) screen <u>7'</u> , <u>133</u> (length) (depth to top) <u>208</u> , <u>Plastic</u> (size) (material) (6) pump <u>3/4</u> , <u>7</u> (HP) (yield gpm) <u>elec</u> (type power) (7) electric log <u>no</u> (yes or no) (organization running log) (8) how well bottom plugged <u>solid</u> | coarse sand | 125 | 140 |
| DRILLERS REMARKS: | | | |


CODED

MISSISSIPPI

DEPT. OF REVENUE

If well telescopes please sketch and show depths.

GROUND LEVEL

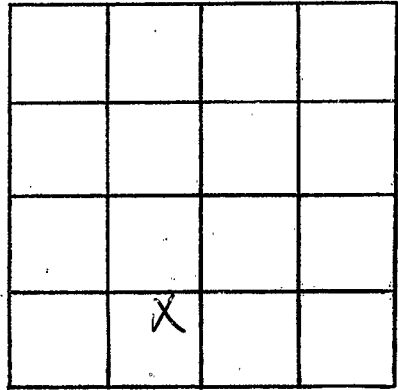

SECTION 8

Please indicate well location X.

ADDITIONAL INFORMATION

If more than one screen, show locations of each on sketch.