

TATE
L 10
8-22-74

MISSISSIPPI
BOARD OF WATER COMMISSIONERS
416 North State Street
Jackson, Mississippi 39201

CODED

WATER WELL DRILLERS LOG

8/22/74 date well completed 1974 Bob Smith & Son firm name Tate county well located


LANDOWNER: Willie Taylor
Shady Grove Rd
Senatobia, MS
(mailing address)

description of formations encountered	from	to
Red Clay	0	18
Big Gravel	18	38
Clay	38	40
Sand + Gravel	40	117
Coarse red sand	117	140

WELL LOCATION:
sec. 7 T 6 N 8 R 8 E
2 miles S of Senatobia
(distance) (direction) (nearest town)

WELL PURPOSE: Home
(home, irrigation, municipal, industrial)

- WELL COMPLETION DATA:
- (1) diameter (inches) 4"
 - (2) total depth (feet) 140'
 - (3) static water level (feet) 95' below above top of ground.
 - (4) casing plastic, 140'
(material) (depth)
(size) if telescope see back.
 - (5) screen 10', 130'
(length) (depth to top)
4", plastic
(size) (material)
 - (6) pump 1/2, 10'
(HP) (yield gpm)
electric
(type power)
 - (7) electric log NO
(yes or no)
 - (organization running log)
 - (8) how well bottom plugged plugged

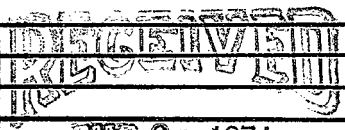


APR 27 1974

MISS. BD. OF WATER COMMISSIONERS

DRILLERS REMARKS:

If well telescopes please sketch and show depths.

GROUND LEVEL

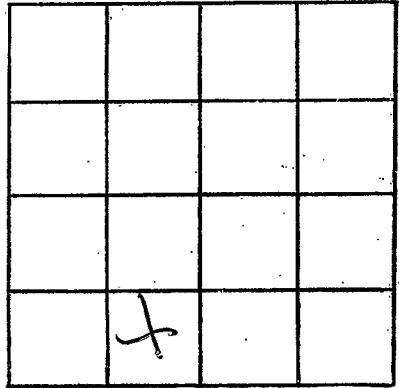

SECTION 7

Please indicate well location X.

ADDITIONAL INFORMATION

If more than one screen,
show locations of each on sketch.