

LATE
L12
2-7-75

MISSISSIPPI
BOARD OF WATER COMMISSIONERS
416 North State Street
Jackson, Mississippi 39201

CODED

WATER WELL DRILLERS LOG

Feb. 7, 1975 Bob Smith Well Drilling Lata
date well completed firm name county well located

LANDOWNER: Robert Yancey Pt. 2 Box 141 Scratchee, Miss. (mailing address)	description of formations encountered	from	to
	Red clay	0'	30'
	Red gravel	30'	75'
	Blue clay	75'	90'
	Course sand	90'	150'

WELL LOCATION:
sec. 13 T. 6 N. R. 8 E
3 miles north of Como
(distance) (direction) (nearest town)

WELL PURPOSE: home
(home, irrigation, municipal, industrial)


- WELL COMPLETION DATA:
- (1) diameter (inches) 4"
 - (2) total depth (feet) 150'
 - (3) static water level (feet) 60' below top of ground.
 - (4) casing plastic, 150'
(material) (depth)
 - (size) if telescope see back.
 - (5) screen 10' length, 140' depth to top
4" plastic
(size) (material)
 - (6) pump 1/2 HP, 8 (yield gpm)
electric (type power)
 - (7) electric log no (yes or no)
 - (organization running log)
 - (8) how well bottom plugged plugged

DRILLERS REMARKS:

177-2 1975
CODED
MISSISSIPPI BOARD OF WATER COMMISSIONERS

If well telescopes please sketch and show depths.

GROUND LEVEL

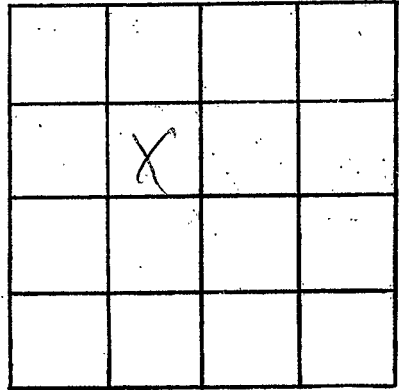

SECTION _____

Please indicate well location X.

ADDITIONAL INFORMATION

If more than one screen, show locations of each on sketch.