

TATE

CODED

MISSISSIPPI BOARD OF WATER COMMISSIONERS
416 North State Street
Jackson, Mississippi 39201

~~RAMONA~~
L13
4-29-75

WATER WELL DRILLERS LOG

TATE

4-29-1975 date well completed
Shubert Well Co. 323 firm name
Ramona county well located

LANDOWNER: Thomas

description of formations encountered from to


Dunnett - Route 2
Como, Miss.
(mailing address)

Red Clay	0	15
Red Sand	15	30
Red Sand + Gravel	30	60
Gravel	60	120
Black Clay	120	180
Black Clay + White Sand	180	195
White Sand	195	205

WELL LOCATION:
sec 14 T 6 N R 8 E
5 miles SW of Senatobia
(distance) (direction) (nearest town)

WELL PURPOSE: Home
(home, irrigation, municipal, industrial)

- WELL COMPLETION DATA:
- (1) diameter (inches) 4 in.
 - (2) total depth (feet) 205
 - (3) static water level (feet) 100 below top of ground.
 - (4) casing Plastic, 205 (material) (depth)
 - (5) screen 7 ft, 198 (length) (depth to top)
4 in., Gravel (size) (material)
 - (6) pump 1/2 (HP) 10 (yield gpm)
Electric 230 (type power)
 - (7) electric log no (yes or no)
 - (8) how well bottom plugged Cap

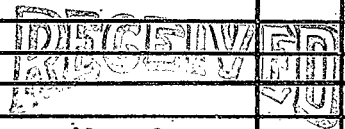


DRILLERS REMARKS:

MAY 20 1975

If well telescopes please sketch and show depths.

GROUND LEVEL

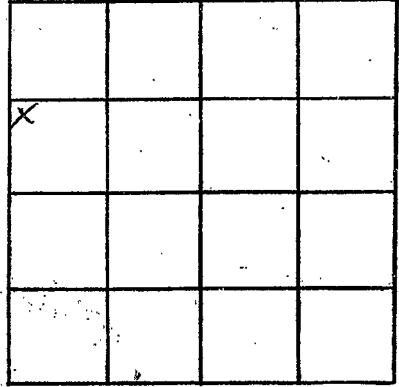

SECTION 14

Please indicate well location X.

ADDITIONAL INFORMATION

If more than one screen, show locations of each on sketch.