

TATE
L 16
4-25-69

MISSISSIPPI
BOARD OF WATER COMMISSIONERS
416 North State Street
Jackson, Mississippi 39201

CODED

WATER WELL DRILLERS LOG

4-25-1969 date well completed Harris Bros. firm name Tate county well located

LANDOWNER: Thurman Eoff
pto 2
Senatobia
(mailing address)

description of formations encountered	from	to
top soil	0	15
gravel	15	55
fine sand	55	80
clay + sand	80	115
coarse sand	115	140

WELL LOCATION:
sec. 16 T. 6 N. R. 8 E.
8 miles S.W. of Senatobia
(distance) (direction) (nearest town)

WELL PURPOSE:
(home, irrigation, municipal, industrial)

- WELL COMPLETION DATA:
- (1) diameter (inches) 4"
 - (2) total depth (feet) 140'
 - (3) static water level (feet) 60 ^(below) _(above) top of ground.
 - (4) casing Plastic 126
(material) (depth)
4"
(size) if telescope see back.
 - (5) screen 14' 126
(length) (depth to top)
008 Plastic
(size) (material)
 - (6) pump 3/4 7
(HP) (yield gpm)
elec.
(type power)
 - (7) electric log no
(yes or no)
 - (organization running log) _____
 - (8) how well bottom plugged Wuck
shot


DRILLERS REMARKS:

DEC 22 1969

MISS. BD. OF
WATER COMMISSIONERS

If well telescopes please sketch and show depths.

GROUND LEVEL

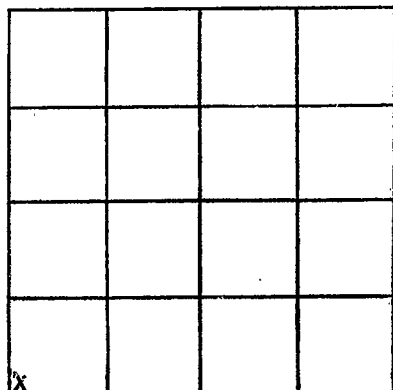

SECTION 16

Please indicate well location X.

ADDITIONAL INFORMATION

If more than one screen,
show locations of each on sketch.