

MISSISSIPPI DEPARTMENT OF ENVIRONMENTAL QUALITY

Office of Land and Water Resources

P. O. Box 10631  
Jackson, MS 39289-0631  
WATER WELL DRILLERS LOG

COUNTY WELL LOCATED PART	
WELL NUMBER L-23	CODEQ
DATE WELL COMPLETED 5-29-03	

PERMIT NUMBER
NAME OF DRILLING FIRM N. MS WELL DRILLING
IF LARG FOR d

NAME & MAILING ADDRESS OF LANDOWNER HAMMER & WILL ESTATES LOT # NO - NO 911 NUMBER SENT TO BIT MS			
Latitude:			
Longitude:			
WELL LOCATION	SEC	TOWNSHIP	RANGE
	12	6 N	9 E
DISTANCE	DIRECTION	NEAREST TOWN	
3	Miles S	of GEN.	
OTHER LANDMARK			
WELL PURPOSE: Home, Irrigation, Municipal, Industrial, Fish Pond, etc. Home			

PUMP DATA			
PUMP TYPE (Circle One): Submersible, Turbine, Jet, Flowing Well, Other (Describe)			
POWER TYPE (Circle One): Electric, Tractor, Diesel, Gasoline, Butane, Other (Describe) H/P 34			

DESCRIPTION OF FORMATIONS ENCOUNTERED	FROM	TO
DIRT	0	20
R. SAND	20	30
GRAVEL	30	50
CITY	50	90
SAND	90	100

RECEIVED	
JUN 10 2003	
BY: OLWR	
Top of Lap Pipe or Reduction in Casing	
FEET	IF TELESCOPED OR MORE THAN ONE SCREEN: USE BACK PAGE

Well Depth 100	Casing Diameter (In.) 4	Casing Length (Ft.) 20
Type of Casing PVC	Hole Depth 100	Depth to Static Water Level 80'
TYPE OF COMPLETION: (Circle One or More): Gravel Packed, Underreamed, Telescoped, Natural Development, Open Hole, Other (Describe)		

WELL GROUTED TO A DEPTH OF 10 FEET  
Type Grout (circle one): Cement, Bentonite, or Mix

SCREEN DATA		
Diameter - Inches 4	Length - Feet 10	Slot Size - Inches .013
Screen Type SLOT PVC	Depth to Bottom - Feet 100	


I certify that the well was drilled, constructed and completed in accordance with all applicable Requirements of the Mississippi Department of Environmental Quality and/or the Mississippi Department of Health regulations and state laws.

Frank Langford 0682  
Signature of Licensed Driller and License No.

6-6-03  
Date

If well telescopes please sketch and show depths.

GROUND LEVEL

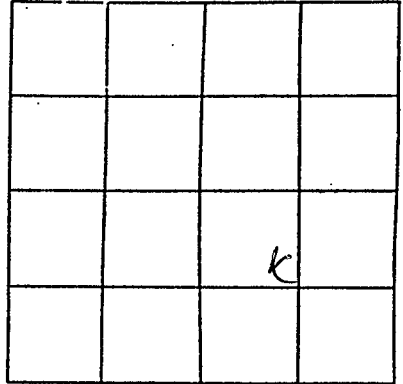

SECTION 12

Please indicate well location X.

Pump Capacity (GPM)	No. of Stages	Setting Depth
<u>12</u>	<u>12</u>	<u>120</u> FT.
PUMP TEST		
Well yielded <u>19 +</u> GPM with a drawdown of <u>2</u> ft. after <u>2</u> hours of pumping		

LOG DATA

TYPE OF LOG RUN (Circle One): No Log Run  
Electric, Gamma Ray, Density, Sonic, Neutron, Other (Describe) \_\_\_\_\_

Name of Organization Running Log \_\_\_\_\_

GEOLOGIC DATA (Office Use Only)

Surface Elev.	Geologic Unit	Unit Thickness	Depth to Top
Subs. SWL	Date	Analysis	Aquifer Test

Driller's Remarks

\_\_\_\_\_  
\_\_\_\_\_  
\_\_\_\_\_  
\_\_\_\_\_

If more than one screen, show location of each on sketch.