

Date
L 2000
6-66

MISSISSIPPI BOARD OF WATER COMMISSIONERS

WATER WELL DRILLERS LOG

Date: 7-23, 1966, Driller: Shelly Keyman County Wate
(Name)


(1) Owner of Land:	Description & Color of Materials Sand, Clay, Red Clay, Shell, etc.	Thick- ness Feet	Depth Feet
<u>Rosborough Co</u> (Name) <u>Senatobia Miss</u> (Address)	<u>Red clay</u>	<u>20</u>	
(2) Location: <u>sw 1/4, nw 1/4, Sec. 1 T6R8</u> <u>4</u> miles <u>W</u> of <u>Senatobia</u> (distance) (direction) (Nearest Town)	<u>Gravel</u>	<u>20</u>	
(3) Topography: <input checked="" type="checkbox"/> (Hilly) <input type="checkbox"/> (Flat) <input type="checkbox"/> (Level)	<u>Red Sand</u>	<u>25</u>	
(4) Purpose of Well: <input checked="" type="checkbox"/> (Domestic Irrigation) <input type="checkbox"/> (Municipal, Industrial, Other)	<u>white clay & sand</u>	<u>20</u>	

Information upon completion of well:

- (1) Diameter 2 inches.
- (2) Total Depth 112 feet.
- (3) Water Level 50 feet below top of ground.
- (4) Cased to 105, Size 2"
- (5) Screen: Size 90, Length 6 ft
- (6) Were any formations sealed against pollution?
_____ yes, C no.

If YES depth of formation _____
Why _____

Drillers Remarks: _____

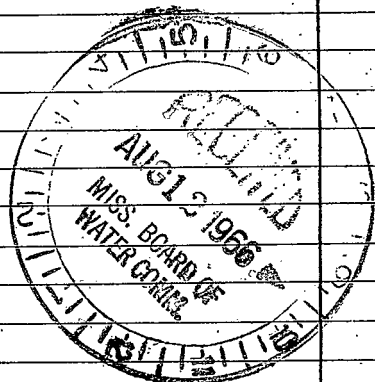

(Use Back Side)

Well No.

[The page contains extremely faint and illegible text, likely bleed-through from the reverse side of the document. No specific content can be transcribed.]