

Tate
 L 2001
 1-20-77

MISSISSIPPI
 BOARD OF WATER COMMISSIONERS
 416 North State Street
 Jackson, Mississippi 39201

WATER WELL DRILLERS LOG

1-20 1977 ¹⁵⁶ *Nick Well Co* Tate
 date well completed firm name county well located

LANDOWNER: *Dr. John M. Gordon*

Senatobia, Ms. 38668
 (mailing address)

WELL LOCATION:
 sec. 9 T. 6 N. R. 128 E.
3 miles SW of Senatobia
 (distance) (direction) (nearest town)

WELL PURPOSE: Home
 (home, irrigation, municipal, industrial)

WELL COMPLETION DATA:

(1) diameter (inches) 4"

(2) total depth (feet) 120'

(3) static water level (feet) 80 below above
 top of ground.

(4) casing PVC 120
 (material) (depth)

(size) If telescope see back.

(5) screen 7ft 113
 (length) (depth to top)

4" Travel Type
 (size) (material)

(6) pump 1/2 10
 (HP) (yield gpm)

220V
 (type power)

(7) electric log NO
 (yes or no)

(organization running log)

(8) how well bottom plugged Cap


description of formations encountered	depth	
	from	to
Clay	0	40
Gravel	40	60
White Clay	60	80
White Sand	80	120

RECEIVED
 FEB 24 1977
 MISS. BD OF WATER COMM

DRILLERS REMARKS:

If well telescopes please sketch and show depths.

GROUND LEVEL

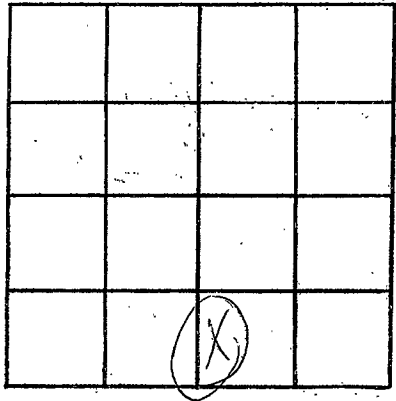

SECTION 8

Please indicate well location X.

ADDITIONAL INFORMATION

If more than one screen,
show locations of each on sketch.