

Date
 6-20-77
 6-7-77

MISSISSIPPI
 BOARD OF WATER COMMISSIONERS
 416 North State Street
 15E Jackson, Mississippi 39201

WATER WELL DRILLERS LOG

6-7 1977 Picks Well Co. Jate
 date well completed firm name county well located

LANDOWNER: James Elom
Rt. 2, Box 148
Senatobia, Mo.
 (mailing address)

description of formations encountered	from	to
<u>Red clay</u>	<u>0</u>	<u>10</u>
<u>Gravel</u>	<u>10</u>	<u>30</u>
<u>Clay</u>	<u>30</u>	<u>90</u>
<u>White Sand</u>	<u>90</u>	<u>147</u>

WELL LOCATION:
 sec. 12 T. 6 N. R. 2 E.
3 1/2 miles S-SW of Senatobia
 (distance) (direction) (nearest town)

WELL PURPOSE: Home
 (home, irrigation, municipal, industrial)

- WELL COMPLETION DATA:
- (1) diameter (inches) 4
 - (2) total depth (feet) 147
 - (3) static water level (feet) 100 below above top of ground.
 - (4) casing PVC, 147,
 (material) (depth)
 (size) if telescope see back.
 - (5) screen 7', 140
 (length) (depth to top)
4", gravel type
 (size) (material)
 - (6) pump 1/2, 10
 (HP) (yield gpm)
220V
 (type power)
 - (7) electric log No
 (yes or no)
- (organization running log)
- (8) how well bottom plugged Cap


DRILLERS REMARKS:

RECEIVED
 JUL 14 1977

MISS. BD. OF WATER COMM

If well telescopes please sketch and show depths.

GROUND LEVEL

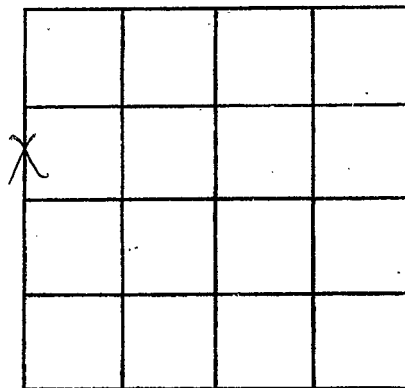

SECTION 12

Please indicate well location X.

ADDITIONAL INFORMATION

If more than one screen, show locations of each on sketch.