

TATE  
L  
2004

MISSISSIPPI  
BOARD OF WATER COMMISSIONERS  
416 North State Street  
Jackson, Mississippi 39201

WATER WELL DRILLERS LOG

7-13 1978 Hicks Well Co Tate  
date well completed firm name county well located

LANDOWNER:	description of formations encountered	from	to
<u>Clay Pitts</u>			
<u>Senatobia, Ms</u> (mailing address)	<u>Red Clay</u>	<u>0</u>	<u>10</u>
	<u>Dravel + Sand</u>	<u>10</u>	<u>110</u>
	<u>White Sand</u>	<u>110</u>	<u>135</u>

WELL LOCATION:  
sec. 1 T. 6 N. R. 8 E.  
3 miles SE of Senatobia  
(distance) (direction) (nearest town)

WELL PURPOSE: Home  
(home, irrigation, municipal, industrial)

WELL COMPLETION DATA:

(1) diameter (inches) 4

(2) total depth (feet) 135

(3) static water level (feet) 90 below above top of ground.

(4) casing PVC, 135  
(material) (depth)

\_\_\_\_\_ if telescope see back.  
(size)

(5) screen 7', 128  
(length) (depth to top)

4", ground type  
(size) (material)

(6) pump 1/2, 10  
(HP) (yield gpm)

220V  
(type power)

(7) electric log No  
(yes or no)

\_\_\_\_\_ (organization running log)

(8) how well bottom plugged Cap

DRILLERS REMARKS:


RECEIVED

AUG - 7 1978

MISSISSIPPI BOARD OF WATER COMMISSIONERS

If well telescopes please sketch and show depths.

GROUND LEVEL

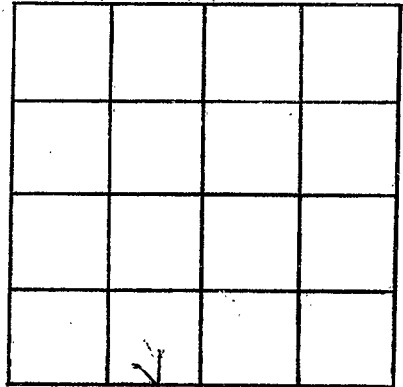

SECTION 1

Please indicate well location X.

ADDITIONAL INFORMATION

If more than one screen,  
show locations of each on sketch.